

LAND CORNER RECORDATION CERTIFICATE
FILING REQUIREMENT OF ACT 74, MICH. P.A.1970

FOR CORNERS OF-- LOCATED IN-- CORNER CODE NUMBER
1. PUBLIC LAND SURVEY T. 26 N. R. 15 W. J-13; K-13
2. PROPERTY CONTROLLING IN SECTION T. N. S., R. E. W.
3. MISCELLANEOUS PROPERTY IN SECTION T. N. S., R. E. W.
4. LOT NO. , RECORDED PLAT
5. PRIVATE CLAIMS

REGISTER OF DEEDS STAMP AND FILING NUMBER

I, Carl F. Roser do hereby certify that under requirements of P.A. 74, Michigan P.A. of 1970, the corner points mentioned in lines 1 and 2 above (identified with circles on index code diagram - over) were, in a field survey on May 17, 1974, established, re-established, monumented, re-monumented, recovered or restored as expressed below and in conformance with regulations and rules therefore as required in the current manual of survey instructions of the United States Department of the Interior, Bureau of Land Management or by a decree of a court of law.

A. Description of original monument and accessories and/or subsequent restoration:

B. Description of corner evidence found and/or method applied in restoring or re-establishing corner:

J-13 Found 3/4 of Sec. 35 as a square, half bar with hook on top; in line with old fence remains to north and in old E-W fence remains.

K-13 Found "T" iron 0.5 foot east of center of N-S blacktop road per previous survey of record by Consumers Power Co.

C. Description of monument for corner and accessories established to perpetuate locating the position of the corner:

Table with 2 columns: J-13 and K-13. J-13 items include Found iron; added DNR monument and cedar post, 12" Maple N85°W 13.9, 5" Maple N03°W 34.7, N 1/4 Sec. 2 (25-15) S89°20'E 5.94. K-13 items include 5/8" "T" iron Power Pole S88°E 70.95, 8" Hemlock N26°W 117.35, 12" Ash N81°W 65.12, 1/2" pipe Due W 31.31, NE Sec. 2 ("T"iron) Due E 9.54.


SIGNED BY Carl F. Roser 8-20-75 DATE

SURVEYOR'S MICHIGAN REGISTRATION NO. 12028

FOR STATE AND UNITED STATES AGENCIES:

SIGNED BY CHIEF OF SURVEY PARTY DATE

APPROVED AND SIGNED BY MICHIGAN REGISTERED LAND SURVEYOR DATE

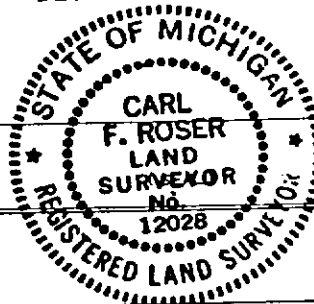

SURVEYOR'S MICHIGAN REGISTRATION NO.

SOUTH PART OF BENZONIA TOWNSHIP

Benzie County