

# LAND CORNER RECORDATION CERTIFICATE

## FILING REQUIREMENT OF ACT 74, MICH. P.A.1970

| FOR CORNERS OF--:                           | LOCATED IN--:  | CORNER CODE NUMBER |
|---|--|--------------------|
| 1. PUBLIC LAND SURVEY _____                 | T. 26 N. R. 15 W. <span style="float: right;">●</span> | G-11; H-11         |
| 2. PROPERTY CONTROLLING IN SECTION 34 _____ | T. 26 N. R. 15 W. <span style="float: right;">●</span> | 3; 15              |
| 3. MISCELLANEOUS PROPERTY IN SECTION _____  | T. _____ N. S. R. _____ E. W.                          |                    |
| 4. LOT NO. _____, RECORDED PLAT _____       |  |                    |
| 5. PRIVATE CLAIMS _____                     |  |                    |

REGISTER OF DEEDS STAMP AND FILING NUMBER

I, Carl F. Roser do hereby certify that under requirements of P.A. 74, Michigan P.A. of 1970, the corner points mentioned in lines 1 and 2 above (identified with circles on index code diagram - over) were, in a field survey on July 15, 1974 1974, established, re-established, monumented, re-monumented, recovered or restored as expressed below and in conformance with regulations and rules therefore as required in the current manual of survey instructions of the United States Department of the Interior, Bureau of Land Management or by a decree of a court of law. Furthermore, that the corner points mentioned in lines 3, 4 and 5 above were, in a field survey on \_\_\_\_\_ 19\_\_\_\_, found, recovered, restored, established or re-established as expressed below and in conformance with the rules of the Michigan State Board of Registration for Land Surveyors or, by a Decree of a Court of law:

~~A. Description of original monument and accessories established and/or re-established~~

C. (continued)

- 15
- Set 1"x36" pipe
  - 6" Cedar S30<sup>0</sup>W 49.55
  - Power Pole S74<sup>0</sup>W 83.44
  - Center E-W b'top county road Due N 4.5
  - Center b'top Co. Rd. S Due E 11.0
  - Cedar post w/loc. tag Due N 33

B. Description of corner evidence found and/or method applied in restoring or re-establishing corner:


- G-11 Found ½" rerod in south edge of blacktop road in line with fence to south.
- H-11 Found ½" rerod in monument box, in approximate 'T' road intersection E-W-S.
- 3 Established corner per standard B.L.M. instructions.
- 15 Established corner per standard B.L.M. instructions.

C. Description of monument for corner and accessories established to perpetuate locating the position of the corner:

| G-11                              | H-11                                    | 3                                |
|-----------------------------------|---|----------------------------------|
| Set 1"x16" pipe over ½" rerod     | Found ½" rerod in monument box          | Set 1¼"x72" pipe & cedar         |
| 10" Cedar S44 <sup>0</sup> W 54.9 | 20" Maple S36 <sup>0</sup> E 48.20      | post w/loc. tag                  |
| 8" Cedar S05 <sup>0</sup> W 52.1  | 15" Twin Apple N43 <sup>0</sup> W 73.20 | 7" Cedar S63 <sup>0</sup> W 42.3 |
| Center E-W b'top county road      |   | 6" Cedar N69 <sup>0</sup> W 35.7 |
| Due N 11.5                        |   | 1½" pipe N01 <sup>0</sup> W 16.2 |
| Cedar post w/loc. tag             |   |                                  |
| Due S 21.5                        |   |                                  |

SIGNED BY Carl F. Roser 8-25-75 DATE \_\_\_\_\_

SURVEYOR'S MICHIGAN REGISTRATION NO. 12028

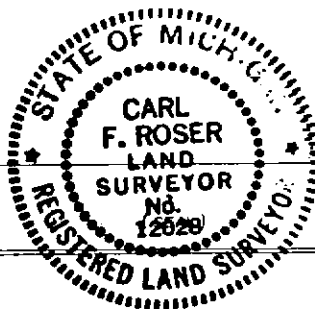

FOR STATE AND UNITED STATES AGENCIES:

SIGNED BY \_\_\_\_\_ DATE \_\_\_\_\_

APPROVED AND SIGNED BY \_\_\_\_\_ DATE \_\_\_\_\_

SURVEYOR'S MICHIGAN REGISTRATION NO. \_\_\_\_\_

SOUTH PART OF Benzie  
BENZONIA TOWNSHIP County