

LAND CORNER RECORDATION CERTIFICATE

FILING REQUIREMENT OF ACT 74, MICH. P.A.1970

| FOR CORNERS OF--: | LOCATED IN--: | CORNER CODE NUMBER |
|---|---|--------------------|
| 1. PUBLIC LAND SURVEY _____ | T. 26 ^{N.} _● , R. 15 ^{W.} _● | G-13; H-13 |
| 2. PROPERTY CONTROLLING IN SECTION 34 _____ | T. 26 ^{N.} _● , R. 15 ^{W.} _● | 11; 12 |
| 3. MISCELLANEOUS PROPERTY IN SECTION _____ | T. _____ ^{N.} _● , R. _____ ^{E.} _● | |
| 4. LOT NO. _____, RECORDED PLAT _____ | | |
| 5. PRIVATE CLAIMS _____ | | |

REGISTER OF DEEDS STAMP AND FILING NUMBER

I, Carl F. Roser do hereby certify that under requirements of P.A. 74, Michigan P.A. of 1970, the corner points mentioned in lines 1 and 2 above (identified with circles on index code diagram - over) were, in a field survey on July 26, 1974, established, re-established, monumented, re-monumented, recovered or restored as expressed below and in conformance with regulations and rules therefore as required in the current manual of survey instructions of the United States Department of the Interior, Bureau of Land Management or by a decree of a court of law. Furthermore, that the corner points mentioned in lines 3, 4 and 5 above were, in a field survey on _____ 19____, found, recovered, restored, established or re-established as expressed below and in conformance with the rules of the Michigan State Board of Registration for Land Surveyors or, by a Decree of a Court of law:

~~A. Description of original monument and accessories and/or subsequent restoration:~~

C. (continued)

12
Set 1"x36" pipe & cedar post
w/loc. tag
14" Maple N27°E 37.52
12" Maple N61°E 63.94
9" Apple S12°E 28.86

B. Description of corner evidence found and/or method applied in restoring or re-establishing corner:

- G-13 Found 3/8" rerod (raised w/1"x12" pipe) in approximate center o- E-W blacktop road, in line with fence to north.
- H-13 Found standard Benzie County monument.
- 11 Center of SW¼ of Section 34 established per standard B.L.M. instructions.
- 12 Set corner by single proportion between found S¼ corner and center of Section 34.

C. Description of monument for corner and accessories established to perpetuate locating the position of the corner:


| G-13 | H-13 | 11 |
|---------------------------------------|--------------------------------------|--|
| Set 1"x12" pipe over found 3/8" rerod | Found Benzie Co. mon. set cedar post | Set 1"x36" pipe, cedar post w/loc. tag |
| 12" Locust S19°W 54.47 | 3" Cherry S19°W 12.84 | 16" Maple N45°E 36.96 |
| 11" Locust S54°W 66.79 | 3" Twin Elm S72°W 18.86 | 10" Ironwood N74°E 28.23 |
| Set cedar post w/loc. tag | 6" Poplar S58°W 11.50 | 9" B. Cherry S22°W 33.08 |
| Due N 33 | (existing BT) | Fence Corner Post S31°E 23± |

SIGNED BY _____

Carl F. Roser 8-25-75

DATE _____

SURVEYOR'S MICHIGAN REGISTRATION NO. 12028

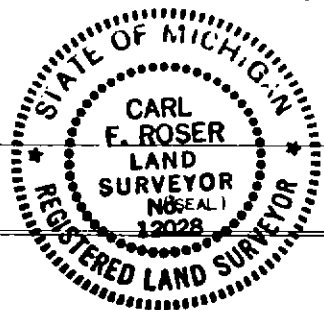

FOR STATE AND UNITED STATES AGENCIES:

SIGNED BY _____

CHIEF OF SURVEY PARTY

DATE _____

APPROVED AND SIGNED BY _____

MICHIGAN REGISTERED LAND SURVEYOR

DATE _____

(SEAL)

SURVEYOR'S MICHIGAN REGISTRATION NO. _____

SOUTH PART OF
BENZONIA TOWNSHIP *Benzie County*