

**LAND CORNER RECORDATION CERTIFICATE**  
**Filing Requirement of Act 74, Mich. P.A. 1970**

For corners in

<u>Benzie</u> (County)	Located In:	Corner Code #
1. Public Land Survey	T 26N R 15W	M-3
	T 26N R 14W	A-3
2. Property Controlling in Section	S _____ T _____ R _____	_____
	S _____ T _____ R _____	_____
3. Miscellaneous Property in Sec.	S _____ T _____ R _____	_____
	S _____ T _____ R _____	_____

Register of Deeds Stamp & File Num.

4. Lot No. \_\_\_\_\_, Recorded Plat \_\_\_\_\_

5. Private Claims \_\_\_\_\_

I, Craig W. McVean, in a field survey on April 22, 19 98 do hereby state that under requirements of P.A. 74, Michigan P.A. of 1970, the corner points mentioned in lines 1 and 2 above were in conformance with regulations and rules therefore as required in the current manual of survey instructions of the United States Department of the Interior, Bureau of Land Management or by a decree of a Court of Law and/or that the corner points mentioned in lines 3, 4 and 5 above were in conformance with the rules of the Michigan Board of Land Surveyors or by a Decree of a Court of Law; established, re-established, monumented, recovered, found as expressed below:

A	B	C	D	E	F	G	H	I	J	K	L	M
1												
2	6	5	4	3	2	1						
3												
4	7	8	9	10	11	12						
5												
6	18	17	16	15	14	13						
7												
8	19	20	21	22	23	24						
9												
10	30	29	28	27	26	25						
11												
12	31	32	33	34	35	36						
13												

**NOTE:** Not more than 2 corners, all in the same town and range, may be recorded on this certificate.

**A. Description of original monument and accessories and/or subsequent restoration:**

M-3 & A-3 -GLO - Set post - Alvin Burt - 1839  
 Cedar 7" S65°W 12L  
 Cedar 5" N62°W 9L  
 -GLO - Correct E. from post - Alvin & Austin Burt - 1839  
 T26N,R14W, Cedar 6" N78°E 7L  
 Cedar 13" S26°E 40L  
 -Co. Bk., P. 159-159 - F. Haswell - 1896 (Sec. 12, T26N,R15W)  
 Drove 4" cedar post 4' deep from OBT's nearly gone.  
 -Co. Bk.II, P. 126 - F. Haswell - No date (Sec. 7, T26N,R14W)  
 Drove cedar post


-Corner Form # 78 - H. Bruning - 1966  
 Found no evidence of Haswell's post. Cor. est. in line w/ fence N-S & 66°N (GLO) of S edge of stream. Set 1"x36" Iron Pipe w/ Alum. Cap. FND. 12" WPS w/ face blaze, S29°W 18.1' FND. 8" Cedar Stp. S29°W 10.55'-flattened face. Cedar 3" N28°E 14.85'  
 Scribed 'X' at 4 1/2' above ground.  
 Spruce 7" S19°E 10.10'  
 Scribed 'T26NR14WS7NBT'  
 Cedar 3" S42°W 13.35'  
 Scribed 'X' at 4 1/2' above ground.  
 Cedar 5" N84°W 14.00'  
 Scribed 'T26NR15WS1NBT'

**B. Description of corner evidence found and/or method applied in restoring or reestablishing corner:**

M-3 & A-3 - Standard Corner common to Sec.'s 1&12, T26N,R15W, & Sec.'s 6&7, T26N,R14W. FND. 4" Benzie Co. Alum. Cap on 1" Iron Pipe per H. Bruning in swamp. South 66° (M&GLO) to S. bank of E. to W. stream. Monument accepted as the best available evidence of the position of the original corner.

**C. Description of monument for corner and accessories established to perpetuate locating the position of the corner:**

M-3 & A-3 - 4" Benzie Co. Alum. Cap on 1" Iron Pipe. Set blue Carsonite post 1' NW. N33°W 65.13' to N&T in E. Side 18" W. Pine - scribed 'XBT'  
 N25°E 14.95' to set N&T in W. Side 5" Cedar - fnd. scribed 'X' (HB)  
 S40°W 13.41' to set N&T in SE. Side 6" Cedar - fnd. scribed 'X' (HB)  
 N88°W 13.91' to set N&T in S. Side 8" Cedar - fnd. scribed 'T26NR14W' (rest rotted) (HB)  
 S13°E 15.69' to set N&T in W. Side 8" Cedar - blazed by others

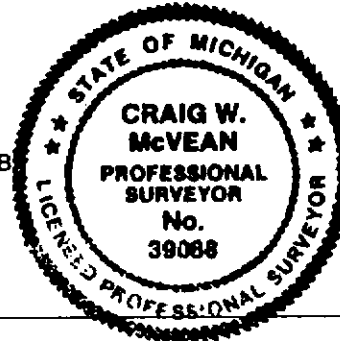

Signed by Craig W. McVean Date 10/6/1998  
 Surveyor's Michigan License No. 39088