

**SURVEY &  
REMONUMENTATION**

MAY - 1 1995

LIBER 2 PAGE 27

COMMISSION

**LAND CORNER RECORDATION CERTIFICATE**  
Filing Requirement of Act 74, Mich. P.A. 1970

For corners in

Benzie (County) Located in: T26N R15W Corner Code # A-9  
M-9

1. Public Land Survey T 26N R 16W  
 T \_\_\_\_\_ R \_\_\_\_\_  
 T \_\_\_\_\_ R \_\_\_\_\_  
 T \_\_\_\_\_ R \_\_\_\_\_

2. Property Controlling S \_\_\_\_\_ T \_\_\_\_\_ R \_\_\_\_\_  
 in Section S \_\_\_\_\_ T \_\_\_\_\_ R \_\_\_\_\_

3. Miscellaneous S \_\_\_\_\_ T \_\_\_\_\_ R \_\_\_\_\_  
 Property in Sec. S \_\_\_\_\_ T \_\_\_\_\_ R \_\_\_\_\_

STATE OF MICHIGAN  
BENZIE COUNTY  
RECORDED

29 DEC 94 4:41 P.M.

MICHELLE R. GRAY  
REGISTER OF DEEDS

Register of Deeds Stamp & File Number

4. Lot No. \_\_\_\_\_, Recorded Plat \_\_\_\_\_  
 5. Private Claims \_\_\_\_\_

	A	B	C	D	E	F	G	H	I	J	K	L	M
2	6	5	4	3	2								
3													
4	7	8	9	10	11	12							
6													
6	18	17	16	15	14	13							
7													
8	19	20	21	22	23	24							
9													
10	30	29	28	27	26	25							
11													
12	31	32	33	34	35	36							
13													

I, John B. Smendzuik, in a field survey on December 15, 19 94, do hereby certify that under requirements of P.A. 74, Michigan P.A. of 1970, the corner points mentioned in lines 1 and 2 above were in conformance with regulations and rules therefore as required in the current manual of survey instructions of the United States Department of the Interior, Bureau of Land Management or by a decree of a Court of Law and/or that the corner points mentioned in lines 3, 4 and 5 above were in conformance with the rules of the Michigan Board of Land Surveyors or by a Decree of a Court of Law; established, re-established, monumented, re-monumented, recovered, found as expressed below:


NOTE: Not more than 4 corners, all in the same town and range, may be recorded on this certificate.

A. Description of original monument and accessories and/or subsequent restoration:

1-9: G.L.O. set post - 9" Beech N20°W 25.08', 12" Beech S70°W 14.52'. Frank Haswell, Surveyor' Record No. 2, Page 122, 1 1/2" iron pipe. 1931 - MDOT survey plans for M-115 show found 1 1/2" iron pipe 615.5' south of centerline. 1949 - Sam Walker survey drawing shows 2" iron pipe found. 1965 - Believe Harold R. Bruning, County Surveyor at this time, doing work in this area set Benzie County cap and iron, stamped 1965, at this position as his notes indicated he found a 1 1/2" iron pipe and was doing extensive work in the area. 1990 Act 74 filed by Smendzuik shows found Benzie County Aluminum Cap and Pipe in place fitting old Harold R. Bruning witnesses to iron pipe. Corner is found 613.87' south of centerline of M-115.

B. Description of corner evidence found and/or method applied in restoring or reestablishing corner:

1-9: Found Benzie County Aluminum Cap and Pipe in place.

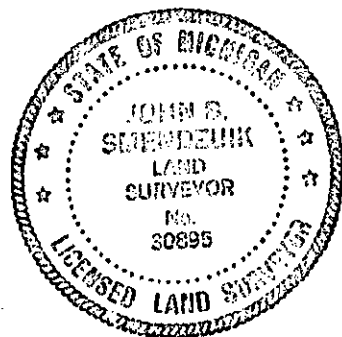

Ratified by Peer Group  
In accordance with P.A. 345  
Chairman John B. Smendzuik  
Date 12/19/94

C. Description of monument for corner and accessories established to perpetuate locating the position of the corner:

1-9: Replaced Aluminum Benzie County Cap and Iron with 3" Ø concrete monument with Benzie County Remonumentation Program Brass Cap.

8" Ironwood N11°E 20.22'  
6" Ironwood S66°E 12.41'  
1/2 iron with cap 30895 South 21.84'

10" Basswood N88°W 3.87'  
8" Maple N6°E 7.90'

Note: All measurements made to double headed nail with brass tag stamped B.C.R.P.

Signed by John B. Smendzuik Date 12/29/94  
Surveyor's Michigan License No. 30895