

**SURVEY &
REMONUMENTATION**

MAY - 1 1995

COMMISSION

LAND CORNER RECORDATION CERTIFICATE
Filing Requirement of Act 74, Mich. P.A. 1970

LIBER 2 PAGE 43

For corners in

Benzie

(County)

Located In:

Corner Code ##

T 26N R 15W

A-10
M-10

1. Public Land Survey

T 26N R 16W

T _____ R _____

T _____ R _____

T _____ R _____

2. Property Controlling
in Section

S _____ T _____ R _____

S _____ T _____ R _____

3. Miscellaneous
Property in Sec.

S _____ T _____ R _____

S _____ T _____ R _____

4. Lot No. _____, Recorded Plat _____

5. Private Claims _____

STATE OF MICHIGAN
BENZIE COUNTY
RECORDED

29 DEC 94 4:45 P.M.

MICHELLE R. GRAY
REGISTER OF DEEDS

Register of Deeds Stamp & File Number

I, John B. Smendzuik, in a field survey on December 15, 19 94,

do hereby certify that under requirements of P.A. 74, Michigan P.A. of 1970, the corner points mentioned in lines 1 and 2 above were in conformance with regulations and rules therefore as required in the current manual of survey instructions of the United States Department of the Interior, Bureau of Land Management or by a decree of a Court of Law and/or that the corner points mentioned in lines 3, 4 and 5 above were in conformance with the rules of the Michigan Board of Land Surveyors or by a Decree of a Court of Law; established, re-established, monumented, re-monumented, recovered, found as expressed below:

NOTE: Not more than 4 corners, all in the same town and range, may be recorded on this certificate.

	A	B	C	D	E	F	G	H	I	J	K	L	M
2	6	5	4	3	2	1							
3													
4	7	8	9	10	11	12							
5													
6	18	17	16	15	14	13							
7													
8	19	20	21	22	23	24							
9													
10	30	29	28	27	26	25							
11													
12	31	32	33	34	35	36							
13													

A. Description of original monument and accessories and/or subsequent restoration:

M-10: G.L.O. set post - 16" Beech N85°E 19.14', 6" Beech S55°W 15.18'. 1983 - 1987 - Garth Baden - found no evidence of corner, set iron and cap M.O.L. landowner added concrete to iron. No Act 74 filed. Information from Baden verbally to this surveyor. 1991 - Smendzuik finds Baden iron in concrete, N-S fence ± 12' east but in old down E-W west. Baden monument not quite at M.O.L. but has been used as 1/4 corner for numerous surveys. Smendzuik left iron in concrete in place.

B. Description of corner evidence found and/or method applied in restoring or reestablishing corner:


M-10: Found Baden iron in concrete as described above and on recorded surveys on file.

Ratified by Peer Group

In accordance with P.A. 345

Chairman John B. Smendzuik

Date 12/19/94

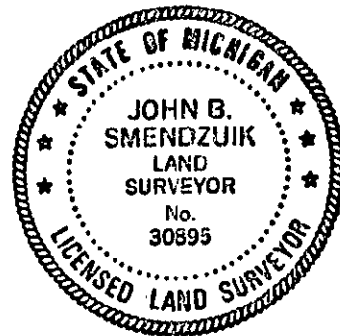

C. Description of monument for corner and accessories established to perpetuate locating the position of the corner:

M-10: Replace Baden iron in concrete with 3" Ø concrete monument with Benzie County Remonumentation Program Brass Cap.

16" Ash N12°W 33.39'

12" Sugar Maple N22°E 7.91'

12" Sugar Maple with blaze S20°E 5.61'

Twin 4 and 6" Sugar Maple with balze and p.k. S78°W 28.61'

Note: All measurements made to double head nails with Benzie County Remonumentation Program Brass Tag.

Signed by John B. Smendzuik
Surveyor's Michigan License No. 30895

Date 12/29/94