SURVEY &
REMONUMENTATION

MAY - 1 1995

COMMISSION

LAND CORNER RECORDATION CERTIFICATE

Filing Requirement of Act 74, Mich. P.A. 1970

LIBER 2 PAGE 44

STATE OF MICHIGAN
BENZIE COUNTY
RECORDED

29 DEC 94 4:45 P.M.

MICHELLE R. GRAY
REGISTER OF DEEDS

Register of Deeds Stamp & File Number

For corners in

Benzie
(County)

	Located In:	Corner Code ##
	T26N R15W	A-11
1. Public Land Survey	T 26N R 16W	M-11
	T ____ R ____	
	T ____ R ____	
	T ____ R ____	
2. Property Controlling	S ____ T ____ R ____	
in Section	S ____ T ____ R ____	
3. Miscellaneous	S ____ T ____ R ____	
Property in Sec.	S ____ T ____ R ____	

4. Lot No. _____ , Recorded Plat _____
5. Private Claims _____

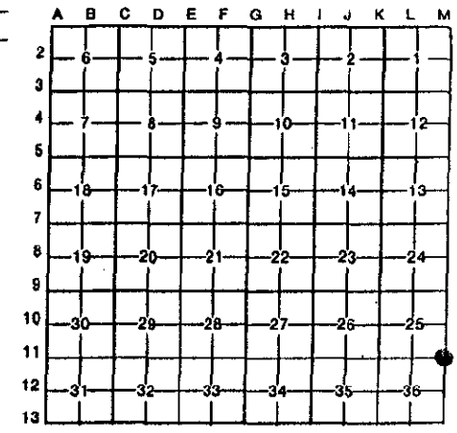

I, John B. Smendzuik, in a field survey on December 15, 19 94, *do hereby certify that under requirements of P.A. 74, Michigan P.A. of 1970, the corner points mentioned* in lines 1 and 2 above were in conformance with regulations and rules therefore as required in the current manual of survey instructions of the United States Department of the Interior, Bureau of Land Management or by a decree of a Court of Law and/or that the corner points mentioned in lines 3, 4 and 5 *above were in conformance with the rules of the Michigan Board of Land Surveyors or by a Decree of a* Court of Law; established, re-established, monumented, re-monumented, recovered, found as expressed below:

NOTE: Not more than 4 corners, all in the same town and range, may be recorded on this certificate.

A. Description of original monument and accessories and/or subsequent restoration:

M-11: G.L.O. set post - 12" Beech S68°W 25.08', 10" Beech N66°W 36.30'. Surveyor's Record No. 2 Page 128, shows break of Section 36. 1977 - Carl Roser/DNR reestablished corner and recorded Act 74. Set DNR monument and cedar post over 1" x 18" pipe with nipple.

B. Description of corner evidence found and/or method applied in restoring or reestablishing corner:

M-11: Found DNR monument of aluminum cap and pipe with cedar post and witnesses in place per Act 74 on record.

Ratified by Peer Group
In accordance with P.A. 345
Chairman John B. Smendzuik
Date 12/19/94

STATE OF MICHIGAN
JOHN B. SMENDZUIK
LAND SURVEYOR
No. 30895
LICENSED LAND SURVEYOR

C. Description of monument for corner and accessories established to perpetuate locating the position of the corner:

M-11: Replaced DNR monument with 3" Ø concrete monument with Benzie County Remonumentation Program Brass Cap.

14" Beech S88°W 40.08'
26" Maple East 43.17'
12" Maple N18°W 21.74'
6" Maple S6°W 31.01'

Note: All measurements made to double headed nail with Benzie County Remonumentation Program Brass Tag.

Signed by John B. Smendzuik Date 12/29/94

Surveyor's Michigan License No. 30895

FORM APPROVED BY MICHIGAN STATE BOARD OF LAND SURVEYORS, JAN. 28, 1971
REVISED MAY 14, 1975
REVISED JAN., 1983