

LAND CORNER RECORDATION CERTIFICATE

FILING REQUIREMENT OF ACT 74, MICH. P.A.1970

FOR CORNERS OF--	LOCATED IN--	CORNER CODE NUMBER
1. PUBLIC LAND SURVEY	T. 26 N. R. 16 W.	K-11; L-11; M-11
2. PROPERTY CONTROLLING IN SECTION 36	T. 26 N. R. 16 W.	1
3. MISCELLANEOUS PROPERTY IN SECTION	T. S. R. E. W.	
4. LOT NO. _____, RECORDED PLAT _____		
5. PRIVATE CLAIMS _____		

REGISTER OF DEEDS STAMP AND FILING NUMBER

I, Carl F. Roser, do hereby certify that under requirements of P.A. 74, Michigan P.A. of 1970, the corner points mentioned in lines 1 and 2 above were, in a field survey on August 12, 1976, established, re-established, monumented, re-monumented, recovered or restored as expressed below and in conformance with regulations and rules therefore as required in the current manual of survey instructions of the United States Department of the Interior, Bureau of Land Management or by a decree of a court of law. Furthermore, that the corner points mentioned in lines 3, 4 and 5 above were, in a field survey on _____, 19____, found, recovered, restored, established or re-established as expressed below and in conformance with the rules of the Michigan State Board of Registration for Land Surveyors or, by a Decree of a Court of law:

A. Description of original monument and accessories and of subsequent restoration
 C. (continued)

1
 Drove 1 1/4"x18" iron pin
 8" W. Pine N63°W 80.50
 P' Pole N23°E 42.49
 Fd. RR spike (Co. Rd. PI)
 N05°48'W 6.83
 Cedar post w/loc. tag
 Due S 26.2


B. Description of corner evidence found and/or method applied in restoring or re-establishing corner:

- K-11 Found 1/2" rerod per County Surveyor H. Bruning, R.L.S.
- L-11 Reestablished N 1/4 corner, Sec. 36, on line between NW & NE corner Sec. 36, & at prorated distance to Haswell survey of Sec. 36 in 1910-1915±, see large brown County Surveyor's Record II, p. 128, at RLS H. Bruning's office in Beulah.
- M-11 Restored NE corner Sec. 36 in line with old wire, fence posts & trees to N and in line with row of old large maple trees with wire in them to E.
- 1 Reestablished 1/16 corner midway & on line between section corner W & 1/4 corner E, which fits Haswell split-up of Sec. 36. Found railroad spike, Co. Road Comm. P.I., is at intersection of b'top roads E-W-N.

C. Description of monument for corner and accessories established to perpetuate locating the position of the corner:

<p>K-11 Fd. bent 1/2" rerod (buried) & drove 1 1/4"x18" iron pin in place 12" Cedar N34°E 44.31 8" Cedar N14°W 46.05 8" Cedar N51°W 70.16 Cedar post S45°E 47' Corner in Center E-W b'top rd.</p>	<p>L-11 Drove 1 1/4"x18" rod in rd. intersection E-W-S P' Pole N62°E 35.75 7" R. Pine N05°E 46.07 8" tw. RPine N63°W 72.80 Set ced. post w/loc. tag Due N 40.0 Fd. RR spk. (Co. Rd. PI) club N26°25'E 7.33 Fd. old 1" pipe N01°40'W 43.76</p>	<p>M-11 Set DNR mon. 1"x36" pipe w/alum. cap over 1"x18" pipe w/nipple & ced. post w/loc. tag 26" Maple S88°E 43.23 10" Maple N18°W 22.00 8" Maple S72°W 19.15 Center N-S ent. rd. to saddle Due E 18'±</p>
---	---	--

SIGNED BY Carl F. Roser
4-18-77
 SURVEYOR'S MICHIGAN REGISTRATION NO. 12028

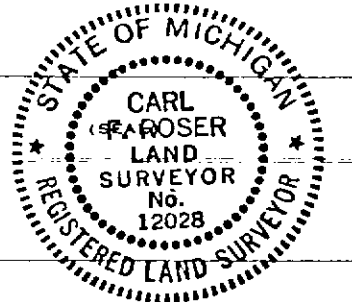

FOR STATE AND UNITED STATES AGENCIES:

SIGNED BY _____ DATE _____
CHIEF OF SURVEY PARTY

APPROVED AND SIGNED BY _____ DATE _____
MICHIGAN REGISTERED LAND SURVEYOR

(SEAL)

SURVEYOR'S MICHIGAN REGISTRATION NO. _____ BENZIE COUNTY