

# LAND CORNER RECORDATION CERTIFICATE

FILING REQUIREMENT OF ACT 74, MICH. P.A.1970

FOR CORNERS OF--	LOCATED IN--	CORNER CODE NUMBER
1. PUBLIC LAND SURVEY	T. 26 N. R. 16 W.	I-12; J-11
2. PROPERTY CONTROLLING IN SECTION 35	T. 26 N. R. 16 W.	10; 16
3. MISCELLANEOUS PROPERTY IN SECTION	T. N. R. E. S. R. W.	
4. LOT NO.	RECORDED PLAT	
5. PRIVATE CLAIMS		

REGISTER OF DEEDS STAMP AND FILING NUMBER

I, Carl F. Roser, do hereby certify that under requirements of P.A. 74, Michigan P.A. of 1970, the corner points mentioned in lines 1 and 2 above were, in a field survey on August 12, 1976, established, re-established, monumented, re-monumented, recovered or restored as expressed below and in conformance with regulations and rules therefore as required in the current manual of survey instructions of the United States Department of the Interior, Bureau of Land Management or by a decree of a court of law. Furthermore, that the corner points mentioned in lines 3, 4 and 5 above were, in a field survey on \_\_\_\_\_, 19\_\_\_\_, found, recovered, restored, established or re-established as expressed below and in conformance with the rules of the Michigan State Board of Registration for Land Surveyors or, by a Decree of a Court of law:

A. Description of original monument and accessories and/or subsequent restoration:

C. (continued)

16  
 Drove 1"x16" Rod  
 7" Cedar N69°E 98.96  
 6" Cedar N67°W 107.15  
 Set cedar post w/loc. tag  
 Due N 33'  
 Center E-W b'top co. road  
 Due N 2'±

B. Description of corner evidence found and/or method applied in restoring or re-establishing corner:

- I-12 Found 3/4" pipe (by MSHD) over found old wooden stake, bricks & stones, w/fence remains to W & S. Corner falls on S side of old E-W tote road (not in use now).
- J-11 Recovered 3/4" pipe by RLS H. Bruning at old corner fence post position (post gone) with old fence remains N-S-E-W.
- 10 Established 1/16 corner equidistant & on line between recovered 1/4 corner to N & section corner to S. Corner falls at old fence corner post, fence remains N-S-E.
- 16 Established E 1/16 on S line of Sec. 35 equidistant & on line between S 1/4 and SE of Sec. 35.

C. Description of monument for corner and accessories established to perpetuate locating the position of the corner:

I-12	J-11	10
Found 3/4"x4'+ pipe & added DNR mon. & cedar post w/loc. tag	Found 3/4" pipe & set cedar post w/loc. tag	Set 1"x36" pipe & cedar post w/loc. tag
3" Cedar N25°W 74.96	13" Maple N12°W 50.82	14" Basswood S26°E 34.34
7" Cedar S89°W 77.00	10" Maple N79°W 44.05	4" Cedar Due N 19.33
	5" W. Pine S21°W 22.30	12" Cedar N62°E 27.62

SIGNED BY Carl F. Roser DATE 4-18-77

SURVEYOR'S MICHIGAN REGISTRATION NO. 12028

FOR STATE AND UNITED STATES AGENCIES:


SIGNED BY \_\_\_\_\_ DATE \_\_\_\_\_

CHIEF OF SURVEY PARTY

APPROVED AND SIGNED BY \_\_\_\_\_ DATE \_\_\_\_\_

MICHIGAN REGISTERED LAND SURVEYOR

(SEAL)

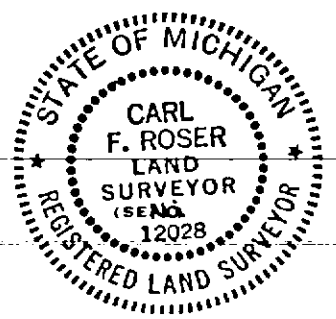

SURVEYOR'S MICHIGAN REGISTRATION NO. \_\_\_\_\_ BENZIE COUNTY