

LAND CORNER RECORDATION CERTIFICATE

FILING REQUIREMENT OF ACT 74, MICH. P.A.1970

FOR CORNERS OF--:	LOCATED IN--:	CORNER CODE NUMBER
1. PUBLIC LAND SURVEY.....	T. 26 N. R. 16 W.	K-13
2. PROPERTY CONTROLLING IN SECTION 36.....	T. 26 N. R. 16 W.	10; 11; 15
3. MISCELLANEOUS PROPERTY IN SECTION.....	T. S. R. E. W.	
4. LOT NO. _____, RECORDED PLAT _____		
5. PRIVATE CLAIMS _____		

REGISTER OF DEEDS STAMP AND FILING NUMBER

I, Carl F. Roser, do hereby certify that under requirements of P.A. 74, Michigan P.A. of 1970, the corner points mentioned in lines 1 and 2 above were, in a field survey on July 29, 1976, established, re-established, monumented, re-monumented, recovered or restored as expressed below and in conformance with regulations and rules therefore as required in the current manual of survey instructions of the United States Department of the Interior, Bureau of Land Management or by a decree of a court of law. Furthermore, that the corner points mentioned in lines 3, 4 and 5 above were, in a field survey on _____, 19____, found, recovered, restored, established or re-established as expressed below and in conformance with the rules of the Michigan State Board of Registration for Land Surveyors or, by a Decree of a Court of law:

A. ~~Description of original monument and accessories and/or subsequent restoration.~~
 C. (continued) 15

- Found 1/2" pipe
- P' Pole N63°W 76.84
- P' Pole N66°E 79.13
- Center E-W b'top rd. (Grace) Due N 3'
- Center b'top rd. S (Bankston) Due E 7.5'
- W 1/8 on N line S-1 (25-16) N89°54'W 6.94
- SW cor. of white cabin N12°W 64.3
- SE cor. of white cabin N13°E 63.2

B. Description of corner evidence found and/or method applied in restoring or re-establishing corner:

- K-13 Recovered old plow point & white limestone 3'± deep per old survey by Geo. Steele, 1871, old surv. record I, p. 102. Also recovered plow landside 3'± deep for NE Sec. 2 (25-16) per Steele survey, 1881, Sur. Record I, p. 100.
- 10 Established 1/16 corner equidistant & on line between recovered W 1/4 corner & SW corner of Sec. 36. Corner falls in flowing Betsie River bypass.
- 11 Established center of SW 1/4 of Sec. 36 per std. split-up of SW 1/4 Sec. 36. Corner falls near easterly side of Mud Flat Island in Betsie River.
- 15 Found 1/2" pipe midway & on line between found SW Sec. 36 & reestablished S 1/4 corner Sec. 36.

C. Description of monument for corner and accessories established to perpetuate locating the position of the corner:

	K-13	10	11
Fd.stk.bottom plow pt. & one white limestone-set DNR mon. & pipe & ced. post w/loc. tag, N00°34'E, 33.00)	Set 1"x36" post w/loc. tag	Drove 1 1/4"x60" pipe & cedar	Drove 1 1/4"x48" pipe & cedar post w/loc. tag
Sec. cor. common to Sec. 1 & 2 (25-16) N89°49'W	14" Ash S08°W 84.5	18" Ash N84°W 28.6	16" Ash S64°W 47.0
30" Maple S76°W 128.20	14" Ash S53°W 45.3		
8" Cedar N38°W 59.15'	12" Ash N14°W 51.9		
Ctr. E-W b'top rd. Due N 3'±			


SIGNED BY Carl F. Roser 4-18-77 DATE _____

SURVEYOR'S MICHIGAN REGISTRATION NO. 12028

FOR STATE AND UNITED STATES AGENCIES:

SIGNED BY _____ DATE _____
CHIEF OF SURVEY PARTY

APPROVED AND SIGNED BY _____ DATE _____
MICHIGAN REGISTERED LAND SURVEYOR

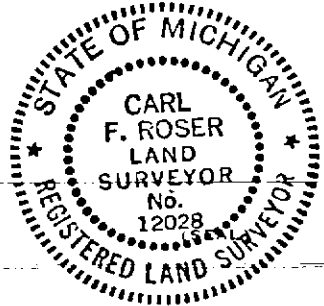

SURVEYOR'S MICHIGAN REGISTRATION NO. _____ BENZIE COUNTY