

**SURVEY & REMONUMENTATION**

APR 07 1998

**LAND CORNER RECORDATION CERTIFICATE**  
 Filing Requirement of Act 74, Mich. P.A. 1970

LIBER 2 PAGE 144

For corners in SECTION

|                                       |                           |               |
|---------------------------------------|---------------------------|---------------|
| <u>Benzie</u><br>(County)             | Located In:               | Corner Code # |
| 1. Public Land Survey                 | T <u>26N</u> R <u>16W</u> | <u>G-6</u>    |
|                                       | T _____ R _____           | _____         |
|                                       | T _____ R _____           | _____         |
|                                       | T _____ R _____           | _____         |
| 2. Property Controlling in Section    | S _____ T _____ R _____   | _____         |
|                                       | S _____ T _____ R _____   | _____         |
| 3. Miscellaneous Property in Sec.     | S _____ T _____ R _____   | _____         |
|                                       | S _____ T _____ R _____   | _____         |
| 4. Lot No. _____, Recorded Plat _____ |                           |               |
| 5. Private Claims _____               |                           |               |

STATE OF MICHIGAN  
 BENZIE COUNTY  
 RECORDED

19 Jan 1998 9:39:55 AM  
 MICHELLE R. GRAY  
 REGISTER OF DEEDS  
 # PAGES one

Register of Deeds Stamp & File Number

I, John B. Smendzuik, in a field survey on December 21, 19 97, do hereby certify that under requirements of P.A. 74, Michigan P.A. of 1970, the corner points mentioned in lines 1 and 2 above were in conformance with regulations and rules therefore as required in the current manual of survey instructions of the United States Department of the Interior, Bureau of Land Management or by a decree of a Court of Law and/or that the corner points mentioned in lines 3, 4 and 5 above were in conformance with the rules of the Michigan Board of Land Surveyors or by a Decree of a Court of Law; established, re-established, monumented, re-monumented, recovered, found as expressed below:

|    |    |   |    |   |    |   |    |   |    |   |    |   |   |
|----|----|---|----|---|----|---|----|---|----|---|----|---|---|
|    | A  | B | C  | D | E  | F | G  | H | I  | J | K  | L | M |
| 2  | 6  |   | 5  |   | 4  |   | 3  |   | 2  |   | 1  |   |   |
| 3  |    |   |    |   |    |   |    |   |    |   |    |   |   |
| 4  | 7  |   | 8  |   | 9  |   | 10 |   | 11 |   | 12 |   |   |
| 5  |    |   |    |   |    |   |    |   |    |   |    |   |   |
| 6  | 18 |   | 17 |   | 16 |   | 15 |   | 14 |   | 13 |   |   |
| 7  |    |   |    |   |    |   |    |   |    |   |    |   |   |
| 8  | 19 |   | 20 |   | 21 |   | 22 |   | 23 |   | 24 |   |   |
| 9  |    |   |    |   |    |   |    |   |    |   |    |   |   |
| 10 | 30 |   | 29 |   | 28 |   | 27 |   | 26 |   | 25 |   |   |
| 11 |    |   |    |   |    |   |    |   |    |   |    |   |   |
| 12 | 31 |   | 32 |   | 33 |   | 34 |   | 35 |   | 36 |   |   |
| 13 |    |   |    |   |    |   |    |   |    |   |    |   |   |

**NOTE: Not more than 4 corners, all in the same town and range, may be recorded on this certificate.**

A. Description of original monument and accessories and/or subsequent restoration:

G-6: 1838: GLO set post - Beech 12" N67°W 9 and Beech 8" N70°E 1.9. Dec. of 1894: Frank S. Haswell, Surveyor's Record 1, page 140, perpetuated the corner with an iron bolt and post. Sept. of 1901: James Pettit, Record of Surveys, page 10, found post and set stones around it. 1958: Grand Traverse Survey Co. found iron at corner. 1974: Harold R. Bruning found a 1 1/2" iron pipe and raised it to the surface with a 1/2" rebar. 1992: John B. Smendzuik found 1 1/2" iron with rebar in top. 1997: Max Harris, Certificate of Survey in Liber 2, Page 857, found 1/2" iron. Smendzuik and Harris witnesses fit witnesses of Bruning. Harris distance also fits well with distance to section corner to the south as measured by Grand Traverse Surveying Co.

B. Description of corner evidence found and/or method applied in restoring or reestablishing corner:


G-6: 1997: Found a 1/2" rebar inside a 1 1/2" x 29" iron pipe about 8" below grade. Iron pipe fits well with previous Smendzuik, Harris and Bruning witnesses. Harris distance also fits well with distance to section corner to the south as measured by Grand Traverse Surveying Co. The Benzie County Peer Group accepted the iron pipe as the perpetuation of the GLO corner at G-6.

Ratified by Peer Group  
 In accordance with P.A. 345  
 Chairman John B. Smendzuik  
 Date 12/10/97

C. Description of monument for corner and accessories established to perpetuate locating the position of the corner:

G-6: Replaced 1/2" rebar in iron pipe with 3" diameter Benzie County Remonumentation Program concrete monument with a brass cap in a monument box. Corner is in a "T" intersection of roads in the Crystal Lake Township North Cemetery.

- SE Cor. of a Conc. Block Bldg. S50°W 45.92'
- NE cor. of a Conc. Block Bldg. S67°W 32.00'
- Peter Lysdall Headstone (SW Cor.) N76°E 34.60'
- Vallette Headstone (NE Cor.) N84°W 24.27'

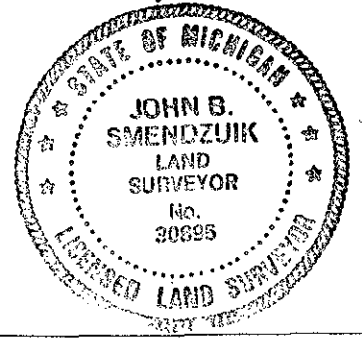

Signed by John B. Smendzuik

Date 1/12/98

Surveyor's Michigan License No. 30895