

APR 07 1998

LIBER 2 PAGE 145

SECTION

LAND CORNER RECORDATION CERTIFICATE
Filing Requirement of Act 74, Mich. P.A. 1970

For corners in Benzie
(County)

Located In: Corner Code #

1. Public Land Survey	T <u>26N</u>	R <u>16W</u>	<u>H-7</u>
	T _____	R _____	_____
	T _____	R _____	_____
	T _____	R _____	_____
2. Property Controlling in Section	S _____	T _____	R _____
	S _____	T _____	R _____
3. Miscellaneous Property in Sec.	S _____	T _____	R _____
	S _____	T _____	R _____

STATE OF MICHIGAN
BENZIE COUNTY
RECORDED

19 Jan 1998 9:40:11 AM
MICHELLE R. GRAY
REGISTER OF DEEDS
PAGES ONE

Register of Deeds Stamp & File Number

- 4. Lot No. _____, Recorded Plat _____
- 5. Private Claims _____

A	B	C	D	E	F	G	H	I	J	K	L	M
2	6	5	4	3	2	1						
3												
4	7	8	9	10	11	12						
5												
6	18	17	16	15	14	13						
7												
8	19	20	21	22	23	24						
9												
10	30	29	28	27	26	25						
11												
12	31	32	33	34	35	36						
13												

John B. Smendzuik in a field survey on December 22, 1997, do hereby certify that under requirements of P.A. 74, Michigan P.A. of 1970, the corner points mentioned in lines 1 and 2 above were in conformance with regulations and rules therefore as required in the current manual of survey instructions of the United States Department of the Interior, Bureau of Land Management or by a decree of a Court of Law and/or that the corner points mentioned in lines 3, 4 and 5 above were in conformance with the rules of the Michigan Board of Land Surveyors or by a Decree of a Court of Law; established, re-established, monumented, re-monumented, recovered, found as expressed below:

NOTE: Not more than 4 corners, all in the same town and range, may be recorded on this certificate.

A. Description of original monument and accessories and/or subsequent restoration:

H-7: 1838: GLO set post - Beech 11" S56°W 32 links and Beech 9" N11°E 20 links. 1875: plat of the Map of First Addition to Frankfort does not show anything. 1890: J.D. Millard in a Township road survey notes corner in place. 1930 (approx.) MDOT found 3/4" square bar and witnesses it. 1975: Harold R. Bruning, LCRC, Liber 1, Page 14, found 3/4" square bar and MDOT witnesses and raised it with iron and cap No. 10681. 1989: Max Harris found Bruning cap and iron. 1993: John B. Smendzuik Bruning cap and iron in monument box. Monument box set by Benzie County Road Commission in repaving of Pautz Road.

B. Description of corner evidence found and/or method applied in restoring or reestablishing corner:


H-7: 1997: Found Bruning iron and cap in monument box in centerline of Graves Road extended and asphalt of Pautz Road. The Benzie County Peer Group accepted the Bruning iron and cap as the best perpetuation of the GLO corner at H-7.

Atified by Peer Group
In accordance with P.A. 345
Chairman [Signature]
Date 12/10/97

C. Description of monument for corner and accessories established to perpetuate locating the position of the corner:

H-7: Left Bruning iron and cap in monument box as found.

- 24" Maple N39°E 68.11' to found spike.
- 20" Twin Maple N16°W 70.83' to found spike and set BCRP nail and tag.
- 16" Maple N70°W 35.92' to found spike.
- 24" Maple S07°W 52.68' to found spike.

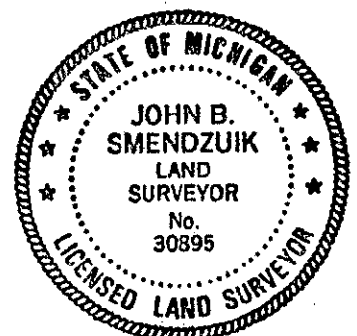

Signed by [Signature]
Surveyor's Michigan License No. 30895

Date 1/18/98