

APR 07 1998

LIBER 2 PAGE 150

**SECTION LAND CORNER RECORDATION CERTIFICATE**  
**Filing Requirement of Act 74, Mich. P.A. 1970**

STATE OF MICHIGAN  
 BENZIE COUNTY  
 RECORDED

19 Jan 1998 9:41:30 AM  
 MICHELLE R. GRAY  
 REGISTER OF DEEDS  
 # PAGES ONE

For corners in  
Benzie

(County)

Located In: Corner Code #

1. Public Land Survey	T <u>26N</u> R <u>16W</u>	<u>I-6</u>
	T _____ R _____	_____
	T _____ R _____	_____
	T _____ R _____	_____
2. Property Controlling in Section	S _____ T _____ R _____	_____
	S _____ T _____ R _____	_____
3. Miscellaneous Property in Sec.	S _____ T _____ R _____	_____
	S _____ T _____ R _____	_____

Register of Deeds Stamp & File Number

4. Lot No. \_\_\_\_\_, Recorded Plat \_\_\_\_\_  
 5. Private Claims \_\_\_\_\_

	A	B	C	D	E	F	G	H	I	J	K	L	M
2	6		5		4		3		2		1		
3													
4	7		8		9		10		11		12		
5													
6	18		17		16		15		14		13		
7													
8	19		20		21		22		23		24		
9													
10	30		29		28		27		26		25		
11													
12	31		32		33		34		35		36		
13													

I, John B. Smendzuik in a field survey on December 22, 19 97, do hereby certify that under requirements of P.A. 74, Michigan P.A. of 1970, the corner points mentioned in lines 1 and 2 above were in conformance with regulations and rules therefore as required in the current manual of survey instructions of the United States Department of the Interior, Bureau of Land Management or by a decree of a Court of Law and/or that the corner points mentioned in lines 3, 4 and 5 above were in conformance with the rules of the Michigan Board of Land Surveyors or by a Decree of a Court of Law; established, re-established, monumented, re-monumented, recovered, found as expressed below:

**NOTE: Not more than 4 corners, all in the same town and range, may be recorded on this certificate.**


A. Description of original monument and accessories and/or subsequent restoration:  
 I-6: 1838: GLO set post - Sugar 16" S68°E 7 links and Beech 10" N88°W 45 links. 1896: Frank S. Haswell, Surveyor's Record 1, page 160, reset 6" hemlock post from original Bearing Trees. 1901: James A. Pettit, Record of Surveys, Page 10, found post and original bearing trees. 1930 (Approx.): Rosewell Wolcott, Survey Record 2, Page 148, found 2" iron pipe by Haswell. 1941: W.D. Manchester survey shows existing 1 1/4" pipe at corner and distances to north and west. 1973: Harold R. Bruning, LCRC, Liber 1, Page 14, found concrete monument and noted 3 witnesses. 1992: John B. Smendzuik found concrete monument and Bruning witnesses. Monument also fits well to Manchester survey distances.

B. Description of corner evidence found and/or method applied in restoring or reestablishing corner:  
 I-6: 1997: Found a 4" square x 4' long concrete monument with large stone on east side of monument. Monument fits well with Smendzuik and Bruning witnesses. The Benzie County Peer Group accepted the concrete monument as the best perpetuation of the GLO corner at I-6.

Ratified by Peer Group  
 In accordance with P.A. 346  
 Chairman [Signature]  
 Date 12/10/97

C. Description of monument for corner and accessories established to perpetuate locating the position of the corner:  
 I-6: Replaced the 4" square concrete monument with a 3" diameter Benzie County Remonumentation Program concrete monument with a brass cap.

- 6" Maple N78°E 32.10' to found nail. (Bruning witness)
- 14" Cherry N19°E 3.96' to set BCRP nail and tag.
- 5" Maple S55°E 42.33' to set BCRP nail and tag.
- 13" Maple S70°W 25.01' to set BCRP nail and tag.
- Bruning triple Black Cherry blown down.

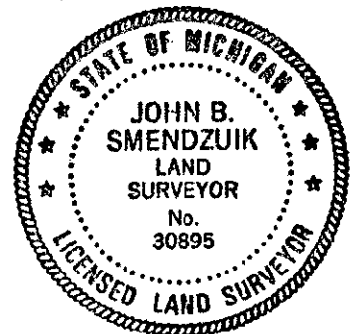

Signed by [Signature]  
 Surveyor's Michigan License No. 30895

Date 1/10/98