

SURVEY & REMONUMENTATION

APR 24 1995

COMMISSION

LAND CORNER RECORDATION CERTIFICATE
Filing Requirement of Act 74, Mich. P.A. 1970

LIBER 2 PAGE 18

STATE OF MICHIGAN
 BENZIE COUNTY
 RECORDED

29 DEC 94 4:39 P.M.

MICHELLE R. GRAY
 REGISTER OF DEEDS

For corners in

Benzie
 (County)

Located In:

Corner Code I-7

- | | | |
|------------------------------------|---------------------------|------------|
| 1. Public Land Survey | T <u>26N</u> R <u>16W</u> | <u>I-7</u> |
| | T _____ R _____ | _____ |
| | T _____ R _____ | _____ |
| | T _____ R _____ | _____ |
| 2. Property Controlling in Section | S _____ T _____ R _____ | _____ |
| | S _____ T _____ R _____ | _____ |
| 3. Miscellaneous Property in Sec. | S _____ T _____ R _____ | _____ |
| | S _____ T _____ R _____ | _____ |
4. Lot No. _____, Recorded Plat _____
5. Private Claims _____

Register of Deeds Stamp & File Number

	A	B	C	D	E	F	G	H	I	J	K	L	M
2	6	5	4	3	2	1							
3													
4	7	8	9	10	11	12							
5													
6	18	17	16	15	14	13							
7													
8	19	20	21	22	23	24							
9													
10	30	29	28	27	26	25							
11													
12	31	32	33	34	35	36							
13													


I, John B. Smendzuik, in a field survey on December 15, 19 94, do hereby certify that under requirements of P.A. 74, Michigan P.A. of 1970, the corner points mentioned in lines 1 and 2 above were in conformance with regulations and rules therefore as required in the current manual of survey instructions of the United States Department of the Interior, Bureau of Land Management or by a decree of a Court of Law and/or that the corner points mentioned in lines 3, 4 and 5 above were in conformance with the rules of the Michigan Board of Land Surveyors or by a Decree of a Court of Law; established, re-established, monumented, re-monumented, recovered, found as expressed below:

NOTE: Not more than 4 corners, all in the same town and range, may be recorded on this certificate.

A. Description of original monument and accessories and/or subsequent restoration:
I-7: G.L.O. set post - 12" Sugar N45°W 29.70', 13" Sugar S76°E 11.22; 1896 - Frank S. Haswell, Surveyor's Record No. 2, Page 160, found stake and set large stone with small ones around it. 1964 - Harold Bruning found large stone with small ones around it. He replaced the stone with a concrete monument with an aluminum cap and recorded the same in the old Surveyor Corner Record. 1992 - B.C.R.C. set monument box over concrete monument with repaving of Graves Road.

B. Description of corner evidence found and/or method applied in restoring or reestablishing corner:
I-7: Found a concrete monument with badly corroded aluminum cap in a monument box.

Ratified by Peer Group
 In accordance with P.A. 345
 Chairman J.B. Smendzuik
 Date 12/19/94

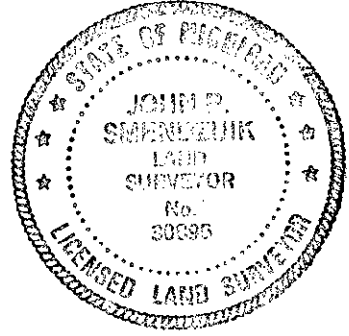

C. Description of monument for corner and accessories established to perpetuate locating the position of the corner:
I-7: Replaced Benzie County Cap and monument with 3" Ø concrete monument with Benzie County Remonumentation Program Brass Cap in a monument box.

- Power Pole S81°E 25.30'
- Stop Sign S65°E 21.81'
- Corner is in centerline of road to west and to south.
- 8" Cherry S54°W 71.46'
- Power Pole N79°W 155.13'

Note: All measurements made to double headed nail with brass tag stamped B.C.R.P.

Signed by J.B. Smendzuik Date 12/29/94
 Surveyor's Michigan License No. 30895