

SURVEY & REMONUMENTATION

APR 07 1998

LIBER 2 PAGE 147

LAND CORNER RECORDATION CERTIFICATE
Filing Requirement of Act 74, Mich. P.A. 1970

For corners in SECTION

For corners in	Located In:	Corner Code #
<u>Benzie</u> (County)		
1. Public Land Survey	T <u>26N</u> R <u>16W</u>	<u>K-6</u>
	T _____ R _____	_____
	T _____ R _____	_____
	T _____ R _____	_____
2. Property Controlling in Section	S _____ T _____ R _____	_____
	S _____ T _____ R _____	_____
3. Miscellaneous Property in Sec.	S _____ T _____ R _____	_____
	S _____ T _____ R _____	_____
4. Lot No. _____, Recorded Plat _____		
5. Private Claims _____		

STATE OF MICHIGAN
BENZIE COUNTY
RECORDED

19 Jan 1998 9:40:41 AM
MICHELLE R. GRAY
REGISTER OF DEEDS
PAGES One

Register of Deeds Stamp & File Number

I, John B. Smendzuik, in a field survey on December 22, 19 97, do hereby certify that under requirements of P.A. 74, Michigan P.A. of 1970, the corner points mentioned in lines 1 and 2 above were in conformance with regulations and rules therefore as required in the current manual of survey instructions of the United States Department of the Interior, Bureau of Land Management or by a decree of a Court of Law and/or that the corner points mentioned in lines 3, 4 and 5 above were in conformance with the rules of the Michigan Board of Land Surveyors or by a Decree of a Court of Law; established, re-established, monumented, re-monumented, recovered, found as expressed below:

	A	B	C	D	E	F	G	H	I	J	K	L	M
2	6	5	4	3	2	1							
3													
4	7	8	9	10	11	12							
6													
6	18	17	16	15	14	13							
7													
8	19	20	21	22	23	24							
9													
10	30	29	28	27	26	25							
11													
12	31	32	33	34	35	36							
13													

NOTE: Not more than 4 corners, all in the same town and range, may be recorded on this certificate.


A. Description of original monument and accessories and/or subsequent restoration:
K-6: 1838: GLO set post - Beech 11" West 7 links and Beech 11" N20°E 9 links. 1896: Frank S. Haswell, Surveyor's Record 1, Page 160, planted hemlock post 3' deep from original bearing trees. Haswell also has distances from 1/4 corner to section corner and 1/16 corner to the south. 1959: Survey by Norton/Kobbins shows stake found and iron set at this corner. 1963: Harold R. Bruning found 1" iron pipe in place and took witnesses.

B. Description of corner evidence found and/or method applied in restoring or reestablishing corner:
K-6: 1997: Found a 1" x 39" iron pipe per Harold Bruning witnesses and survey of 1963 and Norton/Kobbins survey of 1959. The Benzie County Peer Group accepted the iron pipe as the perpetuation of the GLO corner at K-6.

Ratified by Peer Group
In accordance with P.A. 845
Chairman [Signature]
Date 12/10/97

C. Description of monument for corner and accessories established to perpetuate locating the position of the corner:
K-6: Replaced 1" x 39" iron pipe with 3" diameter Benzie County Remonumentation Program concrete monument with a brass cap 4" above grade.

- 10" Hemlock S02°W 9.39' to set BCRP nail and tag. (Bruning witness)
- 16" and 24" Twin Beech S77°E 15.43' to set BCRP nail and tag. (Bruning witness)
- 7" Maple N88°W 27.23' to set BCRP nail and tag
- 10" Ash N38°E 21.04' to set BCRP nail and tag.
- 11" Yellow Birch N82°W 9.25' to set BCRP nail and tag. (Bruning witness, tree dead)
- All Bruning witness trees had blazed faces. Corner is on a east-west woods line change.

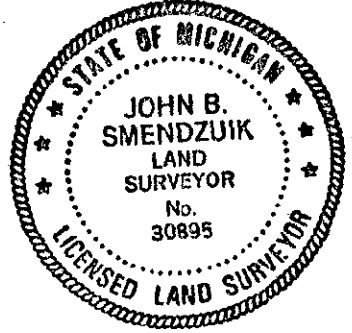

Signed by [Signature] Date 1/18/98
Surveyor's Michigan License No. 30895