SURVEY &
REMONUMENTATION

APR 2 4 1995

COMMISSION

LIBER 2 PAGE 17

STATE OF MICHIGAN
BENZIE COUNTY
RECORDED

29 DEC 94 4:39 P.M.

MICHELLE R. GRAY
REGISTER OF DEEDS

Register of Deeds Stamp & File Number

LAND CORNER RECORDATION CERTIFICATE

Filing Requirement of Act 74, Mich. P.A. 1970

For corners in Benzie (County)

	Located In:	Corner Code ##
1. Public Land Survey	T 26N R 16W	K-8
	T ___ R ___	
	T ___ R ___	
	T ___ R ___	
2. Property Controlling	S ___ T ___ R ___	
in Section	S ___ T ___ R ___	
3. Miscellaneous	S ___ T ___ R ___	
Property in Sec.	S ___ T ___ R ___	

4. Lot No. _____, Recorded Plat _____
5. Private Claims _____

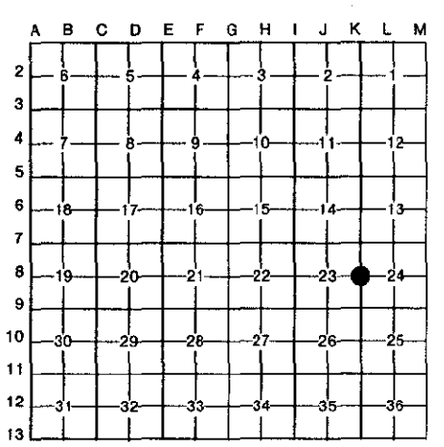

I, John B. Smendzuik, in a field survey on December 15, 19 94, do hereby certify that under requirements of P.A. 74, Michigan P.A. of 1970, the corner points mentioned in lines 1 and 2 above were in conformance with regulations and rules therefore as required in the current manual of survey instructions of the United States Department of the Interior, Bureau of Land Management or by a decree of a Court of Law and/or that the corner points mentioned in lines 3, 4 and 5 above were in conformance with the rules of the Michigan Board of Land Surveyors or by a Decree of a Court of Law; established, re-established, monumented, re-monumented, recovered, found as expressed below:

NOTE: Not more than 4 corners, all in the same town and range, may be recorded on this certificate.

A. Description of original monument and accessories and/or subsequent restoration:

K-8: G.L.O. set post - 15" Hemlock S45°W 17.16', 6" Beech S86°E 6.60'. 1882 - Sam Davidson, Surveyor's Record No. 1, Page 127, set new post by old bearing trees and noted corner north of 1/2 way position. Frank Haswell, Surveyor's Record No. 2, Page 122 - iron rod with stones around it set by Haswell for highway survey-original witnesses. 1963 - Harold R. Bruning found 1 1/8 x 3' iron shaft with gear with stones around it in place. Replaced it with a concrete monument with aluminum cap.

B. Description of corner evidence found and/or method applied in restoring or reestablishing corner:

K-8: Found concrete monument with Benzie County Aluminum Cap.

Ratified by Peer Group
in accordance with P.A. 345
Chairman John B. Smendzuik
Date 12/19/94

STATE OF MICHIGAN
JOHN B. SMENDZUIK
LAND SURVEYOR
No. 30895
LICENSED LAND SURVEYOR

C. Description of monument for corner and accessories established to perpetuate locating the position of the corner:

K-8: Replaced concrete monument with aluminum cap with 3" Ø concrete monument with Benzie County Remonumentation Program Brass Cap.

8" Ironwood N34°W 13.66'
8" Hard Maple S74°W 24.06'
12"White Pine N77°E 25.80'
10" Hard Maple S42°E 32.11'

Note: All measurements made to double headed nail with brass tag stamped B.C.R.P.

Signed by John B. Smendzuik Date 12/29/94

Surveyor's Michigan License No. 30895

FORM APPROVED BY MICHIGAN STATE BOARD OF LAND SURVEYORS, JAN. 28, 1971
REVISED MAY 14, 1975
REVISED JAN., 1983