

SURVEY & REMONUMENTATION

APR 24 1995

COMMISSION

LAND CORNER RECORDATION CERTIFICATE Filing Requirement of Act 74, Mich. P.A. 1970

LIBER 2 PAGE 28

For corners in

<u>Benzie</u> <small>(County)</small>	Located In:	Corner Code <u>K-11</u>
1. Public Land Survey	T <u>26N</u> R <u>16W</u>	<u>K-11</u>
	T _____ R _____	_____
	T _____ R _____	_____
	T _____ R _____	_____
2. Property Controlling in Section	S _____ T _____ R _____	_____
	S _____ T _____ R _____	_____
3. Miscellaneous Property in Sec.	S _____ T _____ R _____	_____
	S _____ T _____ R _____	_____
4. Lot No. _____, Recorded Plat _____		
5. Private Claims _____		

STATE OF MICHIGAN
BENZIE COUNTY
RECORDED

29 DEC 94 4:41 P.M.

MICHELLE R. GRAY
REGISTER OF DEEDS

Register of Deeds Stamp & File Number

I, John B. Smendzuik, in a field survey on December 15, 19 94, do hereby certify that under requirements of P.A. 74, Michigan P.A. of 1970, the corner points mentioned in lines 1 and 2 above were in conformance with regulations and rules therefore as required in the current manual of survey instructions of the United States Department of the Interior, Bureau of Land Management or by a decree of a Court of Law and/or that the corner points mentioned in lines 3, 4 and 5 above were in conformance with the rules of the Michigan Board of Land Surveyors or by a Decree of a Court of Law; established, re-established, monumented, re-monumented, recovered, found as expressed below:

NOTE: Not more than 4 corners, all in the same town and range, may be recorded on this certificate.

	A	B	C	D	E	F	G	H	I	J	K	L	M
2	6	5	4	3	2	1							
3													
4	7	8	9	10	11	12							
5													
6	18	17	16	15	14	13							
7													
8	19	20	21	22	23	24							
9													
10	30	29	28	27	26	25							
11													
12	31	32	33	34	35	36							
13													


A. Description of original monument and accessories and/or subsequent restoration:

K-11: G.L.O. set post - 12" Cedar N67°W 6.60', 12" Hemlock N36°E 11.88'. Surveyor's Record No. 2 Page 128, show break of Section 36 with number across north line. Carl Roser/DNR - found 1/2" rerod per County Surveyor H.R. Bruning and filed Act 74. Good fence line to south. DNR set 1 1/4" x 18" rod over bent 1/2" rerod.

B. Description of corner evidence found and/or method applied in restoring or reestablishing corner:

K-11: Found 1 1/4" IRON APE: 29" BELOW ROAD GRADE AND IN OLD COURDARN ROAD BED. 1 1/4" x 15" IRON BAR AT SURFACE NOT OVER IRON BELOW. DROVE 1 1/4" IRON APE DOWN AND SET MONUMENT.

Ratified by Peer Group
In accordance with P.A. 345
Chairman John B. Smendzuik
Date 12/19/94

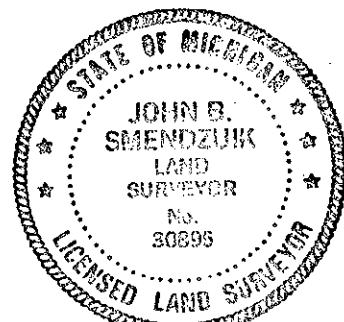

C. Description of monument for corner and accessories established to perpetuate locating the position of the corner:

K-11: Replaced 1 1/4" APE with 3" Ø concrete monument with Benzie County Remonumentation Program Brass Cap in a monument box.

14" W. BIRCH N13°E 39.09' 8" CEDAR N13°W 46.14'
12" RED MAPLE N26°W 43.12' 8" Ø PAST SOUTH 32.00'

NOTE: ALL MEASUREMENTS MADE TO NAIL W/ BRASS TAG STAMPED B.C.R.P.

Signed by John B. Smendzuik Date 12/29/94
Surveyor's Michigan License No. 30895