

SURVEY & REMONUMENTATION

APR 24 1995

COMMISSION

LIBER 2 PAGE 45

LAND CORNER RECORDATION CERTIFICATE
Filing Requirement of Act 74, Mich. P.A. 1970

For corners in

<u>Benzie</u> <small>(County)</small>	Located In:	Corner Code \neq
1. Public Land Survey	T <u>26N</u> R <u>16W</u>	<u>L-7</u>
	T _____ R _____	_____
	T _____ R _____	_____
	T _____ R _____	_____
2. Property Controlling in Section	S _____ T _____ R _____	_____
	S _____ T _____ R _____	_____
3. Miscellaneous Property in Sec.	S _____ T _____ R _____	_____
	S _____ T _____ R _____	_____
4. Lot No. _____, Recorded Plat _____		
5. Private Claims _____		

STATE OF MICHIGAN
 BENZIE COUNTY
 RECORDED

29 DEC 94 4:45 P.M.

MICHELLE R. GRAY
 REGISTER OF DEEDS

Register of Deeds Stamp & File Number

	A	B	C	D	E	F	G	H	I	J	K	L	M
2	6	5	4	3	2	1							
3													
4	7	8	9	10	11	12							
5													
6	18	17	16	15	14	13							
7													
8	19	20	21	22	23	24							
9													
10	30	29	28	27	26	25							
11													
12	31	32	33	34	35	36							
13													

I, John B. Smendzuik, in a field survey on December 15, 19 94, do hereby certify that under requirements of P.A. 74, Michigan P.A. of 1970, the corner points mentioned in lines 1 and 2 above were in conformance with regulations and rules therefore as required in the current manual of survey instructions of the United States Department of the Interior, Bureau of Land Management or by a decree of a Court of Law and/or that the corner points mentioned in lines 3, 4 and 5 above were in conformance with the rules of the Michigan Board of Land Surveyors or by a Decree of a Court of Law; established, re-established, monumented, re-monumented, recovered, found as expressed below:

NOTE: Not more than 4 corners, all in the same town and range, may be recorded on this certificate.


A. Description of original monument and accessories and/or subsequent restoration:

L-7: G.L.O. set post - 8" Beech N15°E 12.54', 8" beech S1°E 13.20. Frank Haswell, Survey Record No. 2, Page 98 - set new post. Frank Haswell, Survey Record No. 2, Page 122, set iron pipe from original witness trees. 1963 - Harold R. Bruning found 3/4" x 28" galvanized iron pipe accepted and used as the 1/4 corner. Set Benzie County Aluminum Cap and Iron. And recorded in old surveyor's corner records.

B. Description of corner evidence found and/or method applied in restoring or reestablishing corner:

L-7: Found Aluminum Benzie County Cap (cracked) and iron with scribed witnessess in place.

Ratified by Peer Group
 In accordance with P.A. 345
 Chairman [Signature]
 Date 12/19/94

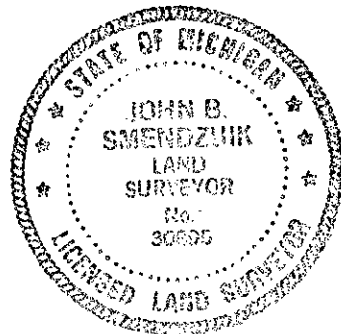

C. Description of monument for corner and accessories established to perpetuate locating the position of the corner:

L-7: Replaced Aulminum cap and pipe with 3" Ø concrete monument with Benzie County Remonumentation Program Brass Cap.

12" Sugar Maple S86°E 25.74' Note: All measurements to double headed nails with Benzie County Remonumentation Program Brass Tag.
 12" Black Cherry N40°W 19.56'
 12" Sugar Maple with scribe N74°W 2.83'
 12" Sugar Maple with scribe S12°E 14.80'

Signed by [Signature] Date 12/29/94
 Surveyor's Michigan License No. 30895