

SURVEY & REMONUMENTATION

APR 07 1998

LIBER 2 PAGE 148

LAND CORNER RECORDATION CERTIFICATE
Filing Requirement of Act 74, Mich. P.A. 1970

SECTION

For corners in
BENZIE
(County)

Located In: Corner Code #

- 1. Public Land Survey T 26N R 16W Meander Corner
T _____ R _____
T _____ R _____
T _____ R _____
- 2. Property Controlling S _____ T _____ R _____
in Section S _____ T _____ R _____
- 3. Miscellaneous S _____ T _____ R _____
Property in Sec. S _____ T _____ R _____

No. 5

STATE OF MICHIGAN
BENZIE COUNTY
RECORDED

19 Jan 1998 9:40:55 AM
MICHELLE R. GRAY
REGISTER OF DEEDS
PAGES One

Register of Deeds Stamp & File Number

- 4. Lot No. _____, Recorded Plat _____
- 5. Private Claims _____

I, John B. Smendzuik, in a field survey on December 22, 19 97, do hereby certify that under requirements of P.A. 74, Michigan P.A. of 1970, the corner points mentioned in lines 1 and 2 above were in conformance with regulations and rules therefore as required in the current manual of survey instructions of the United States Department of the Interior, Bureau of Land Management or by a decree of a Court of Law and/or that the corner points mentioned in lines 3, 4 and 5 above were in conformance with the rules of the Michigan Board of Land Surveyors or by a Decree of a Court of Law; established, re-established, monumented, re-monumented, recovered, found as expressed below:

	A	B	C	D	E	F	G	H	I	J	K	L	M
2	6	5	4	3	2	1							
3													
4	7	8	9	10	11	12							
5													
6	18	17	16	15	14	13							
7													
8	19	20	21	22	23	24							
9													
10	30	29	28	27	26	25							
11													
12	31	32	33	34	35	36							
13													

NOTE: Not more than 4 corners, all in the same town and range, may be recorded on this certificate.


A. Description of original monument and accessories and/or subsequent restoration:
G-6 Meander Corner: 1838: GLO set post - Hemlock 12" S3°E 29 links and Cedar 11" S51°W 15 links. 1894: Frank S. Haswell, Surveyors Record 1, Page 140, shows he set stake south of the Meander Corner. 1917: Frank S. Haswell, signed plat of Bellows Beach which shows 1" x 3' iron pipe set at corner. 1954: Henry J. Kleinhuizen survey shows distance between Meander corners. Also around this time, Kleinhuizen does unrecorded plat of Supervisor's Plat of Bellows Beach which shows a concrete monument at this corner. 1974: Harold R. Bruning shows found square concrete monument and witnesses it. 1994: John B. Smendzuik, Finds concrete monument and remaining Bruning witnesses. Monument also fits well with GLO and Kleinhuizen distances to the Meander corner to the Northwest and to Kleinhuizen iron to south and with plat of Bellows Beach irons.

B. Description of corner evidence found and/or method applied in restoring or reestablishing corner:
G-6 Meander Corner: 1997: Found a 4" square concrete monument x 3' long at position of remaining Bruning witnesses. The Benzie County Peer Group accepted the square concrete monument as the perpetuation of the GLO Meander Corner north of G-6.

Ratified by Peer Group
In accordance with P.A. 345
Chairman [Signature]
Date 12/10/97

C. Description of monument for corner and accessories established to perpetuate locating the position of the corner:
G-6 Meander Corner: Replaced 4" square concrete monument with a 3" diameter Benzie County Remonumentation Program concrete monument with a brass cap.

- 10" Cedar N38°E 15.68' to set BCRP nail and tag. (Bruning witness tree, new nail)
- 18" Maple N76°W 22.65" to set BCRP nail and tag. (Bruning witness tree, new nail)
- Service Pole S39°E 2.47' to set BCRP nail and tag.
- 12" Maple S06°E 14.33' to set BCRP nail and tag.

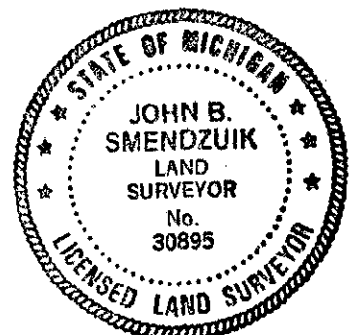

Signed by [Signature]

Date 1/10/98

Surveyor's Michigan License No. 30895