

LAND CORNER RECORDATION CERTIFICATE
FILING REQUIREMENT OF ACT 74, MICH. P.A.1970

FOR CORNERS OF-- LOCATED IN-- CORNER CODE NUMBER
1. PUBLIC LAND SURVEY... T. 27 N. R. 13 E. G-2; H-3; I-2; I-3
2. PROPERTY CONTROLLING IN SECTION... T. N. S. R. E. W.
3. MISCELLANEOUS PROPERTY IN SECTION... T. N. S. R. E. W.
4. LOT NO. ... RECORDED PLAT
5. PRIVATE CLAIMS

REGISTER OF DEEDS STAMP AND FILING NUMBER

I, Carl F. Roser do hereby certify that under requirements of P.A. 74, Michigan P.A. of 1970, the corner points mentioned in lines 1 and 2 above (identified with circles on index code diagram - over) were, in a field survey on 4-25 1973, established, re-established, monumented, re-monumented, recovered or restored as expressed below and in conformance with regulations and rules therefore as required in the current manual of survey instructions of the United States Department of the Interior, Bureau of Land Management or by a decree of a court of law. Furthermore, that the corner points mentioned in lines 3, 4 and 5 above were, in a field survey on 19... found, recovered, restored, established or re-established as expressed below and in conformance with the rules of the Michigan State Board of Registration for Land Surveyors or, by a Decree of a Court of law:

Description of original monument and accessories and/or subsequent restoration:

- C. Continued: I-3
FD. 3/4" sq. iron
Added 1"x18" pipe
8" R. Pine N82E 24.60
7" R. Pine S30E 85.30
6" R. Pine S40W 50.00
On ctr. Int. B. top Co RD. N-S-E-W.
Cedar Post w/loc tag N45W 50'

B. Description of corner evidence found and/or method applied in restoring or re-establishing corner:

- G-2 Accepted recovered iron & rock as proper 1/4 corner.
H-3 Recovered 3/4"x30" pipe in road intersection. Old corner of record.
I-2 Recovered iron from Wolcott survey of record (1938).
I-3 Found 3/4" square iron in center of road intersection.

C. Description of monument for corner and accessories established to perpetuate locating the position of the corner:

- G-2 Fd. 1 1/2" Iron & 8"x16" rock added DNR Mon. & Ced.Gd.Post
10" Maple S12E 32.0'
4" Maple S79W 4.4'
5" Maple N28E 28.7'
6" tw IronwdN71E 43.8'
Midway on steep W'y slope 80' High
H-3 Fd. Pipe - Added DNR Mon.
24" Maple N26W 51.70'
7" R.Pine N40E 58.91
8" R. Pine N61E 72.45
Set Ced.Post & loc tag Due W 33'
On ctr line Co.Rd. N-S-E
I-2 Set DNR Mon. over 1/2" pipe
12" Maple N69W 49.7'
14" Maple S64E 50.1'
9" Ironwood S72W 58.1'
Set Ced. post & loc tag Due W 33'
Ctr Ln N-S Co. Rd Due W 2'


SIGNED BY Carl F. Roser DATE 7-16-73

SURVEYOR'S MICHIGAN REGISTRATION NO. 12028

FOR STATE AND UNITED STATES AGENCIES:

SIGNED BY CHIEF OF SURVEY PARTY DATE

APPROVED AND SIGNED BY MICHIGAN REGISTERED LAND SURVEYOR DATE

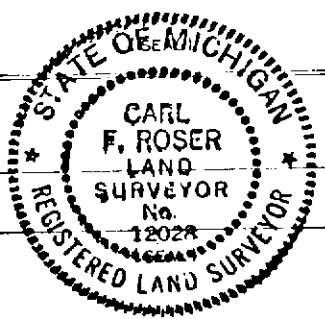

SURVEYOR'S MICHIGAN REGISTRATION NO.