

APR 14 1998

LIBER 2 PAGE 106

SECTION

LAND CORNER RECORDATION CERTIFICATE  
Filing Requirement of Act 74, Mich. P.A. 1970

For corners in

BENZIE

(County)

Located in:

Corner Code #

1. Public Land Survey

T 27N R 13W A-11  
T \_\_\_ R \_\_\_  
T \_\_\_ R \_\_\_  
T \_\_\_ R \_\_\_  
T \_\_\_ R \_\_\_  
S \_\_\_ T \_\_\_ R \_\_\_  
S \_\_\_ T \_\_\_ R \_\_\_  
S \_\_\_ T \_\_\_ R \_\_\_  
S \_\_\_ T \_\_\_ R \_\_\_

2. Property Controlling in Section

3. Miscellaneous Property in Sec.

4. Lot No. \_\_\_\_\_, Recorded Plat \_\_\_\_\_  
5. Private Claims \_\_\_\_\_

STATE OF MICHIGAN  
BENZIE COUNTY  
RECORDED

15 Jan 1998 4:17:17 PM  
NICHELLE R. GRAY  
REGISTER OF DEEDS  
# PAGES One

Register of Deeds Stamp & File Number

I, CARL KIISKILA, in a field survey on JUNE 27, 1976 do hereby state that under requirements of P.A. 74, Michigan P.A. of 1970, the corner points mentioned in lines 1 and 2 above were in conformance with regulations and rules therefore as required in the current manual of survey instructions of the United States Department of the Interior, Bureau of Land Management or by a decree of a Court of Law and /or that the corner points mentioned in lines 3, 4 and 5 above were in conformance with the rules of the Michigan Board of Land Surveyors or by a Decree of a Court of Law; established, re-established, monumented, recovered, found as expressed below:

NOTE: Not more than 2 corners, all in the same town and range, may be recorded on this certificate.

	A	B	C	D	E	F	G	H	I	J	K	L	M
1													
2	6		5		4		3		2		1		
3													
4	7		8		9		10		11		12		
5													
6	18		17		16		15		14		13		
7													
8	19		20		21		22		23		24		
9													
10	30		29		28		27		26		25		
11													
12	31		32		33		34		35		36		
13													

A. Description of original monument and accessories and/or subsequent restoration:

M-11

G.L.O. SET POST - 16" BEECH N54°E 17.8', 15" BEECH S58°E 24.4', 9" BEECH S12°W 9.9' AND 20" BEECH N57°W 40.9'. NO EVIDENCE OF THIS G.L.O. POST OR BEARING TREES WAS FOUND.

Ratified by Peer Group  
In accordance with P.A. 345

Chairman [Signature]

Date 12/18/95

B. Description of corner evidence found and/or method applied in restoring or reestablishing corner:


M-11

IT WAS DETERMINED TO RESTORE THE LOST CORNER BY DOUBLE PROPORTIONATE MEASUREMENT AS OPPOSED TO STRICT SINGLE PROPORTIONATE MEASUREMENT METHOD WHICH IS NORMAL FOR LOST CORNERS ON TOWNSHIP LINES. IT IS THE OPINION OF MICHIGAN DEPARTMENT OF NATURAL RESOURCES SURVEYORS THAT THE 1850 (GLO) MEASUREMENTS WERE MORE RELIABLE IN FOUR CARDINAL DIRECTIONS THAN A STRAIGHT LINE BETWEEN CONTROLLING CORNERS 3 MILES APART TO THE NORTH AND SOUTH. REESTABLISHED THE SE COR OF SEC 25 BY DOUBLE PROPORTIONATE MEASUREMENT BETWEEN FOUND CORNERS 2 MILES TO THE NORTH AND 1 MILE TO THE EAST, WEST AND SOUTH. CTR OF WINDING E-W 2-TRACK IS 2' NORTH.

C. Description of monument for corner and accessories established to perpetuate locating the position of the corner:

M-11

SET 4"x 36" CONC MON W/BRASS CAP (BENZIE CO REMON MON).  
28" HEMLOCK N12°E 12.91'  
9" S. MAPLE N60°E 55.49'  
10" MAPLE S84°E 64.93'  
6" MAPLE S66°E 78.60'  
SET CARSONITE POST WITH LOCATION TAG NORTH 16.5'

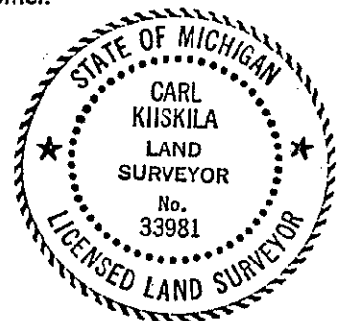

Signed by Carl T. Kiiskila

Date 4-8-97

Surveyor's Michigan License No. 33981