SURVEY & REMONUMENTATION

APR 14 1998

SECTION

LIBER 2 PAGE 73

LAND CORNER RECORDATION CERTIFICATE
Filing Requirement of Act 74, Mich. P.A. 1970

For corners in

BENZIE
(County)

STATE OF MICHIGAN
BENZIE COUNTY
RECORDED

15 Jan 1998 4:08:40 PM
MICHELLE R. GRAY
REGISTER OF DEEDS
PAGES one

Register of Deeds Stamp & File Number

	Located In:			Corner Code #
1. Public Land Survey		T 27N	R 13W	C-10
		T___	R___	
		T___	R___	
		T___	R___	
2. Property Controlling	S___	T___	R___	
in Section	S___	T___	R___	
3. Miscellaneous	S___	T___	R___	
Property in Sec.	S___	T___	R___	

4. Lot No. _____, Recorded Plat _____
5. Private Claims _____

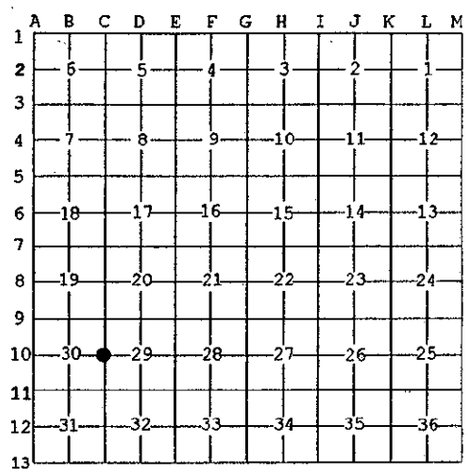

I, CARL KIISKILA, in a field survey on OCTOBER 22, 19 96 do hereby state that under requirements of P.A. 74, Michigan P.A. of 1970, the corner points mentioned in lines 1 and 2 above were in conformance with regulations and rules therefore as required in the current manual of survey instructions of the United States Department of the Interior, Bureau of Land Management or by a decree of a Court of Law and /or that the corner points mentioned in lines 3, 4 and 5 above were in conformance with the rules of the Michigan Board of Land Surveyors or by a Decree of a Court of Law; established, re-established, monumented, recovered, found as expressed below:

NOTE: Not more than 2 corners, all in the same town and range, may be recorded on this certificate.

A. Description of original monument and accessories and/or subsequent restoration:
C-10
G.L.O. SET POST - 32" HEMLOCK S66°E 29.0' AND 24" HEMLOCK N06°W 19.8'. WM. B. BATZER, 1975 L.C.R.C. IN LIBER 1, PAGE 118 FOUND 1" IRON BAR. MICH DNR, JAN 1993, FOUND A 1" PINCH PIPE FITTING WM. B. BATZER 1975 WITNESSES.

B. Description of corner evidence found and/or method applied in restoring or reestablishing corner:
C-10
FOUND 1" PINCH PIPE FITTING WM. B. BATZER 1975 WITNESSES.

Ratified by Peer Group
In accordance with P.A. 345
Chairman [signature]
Date 7/24/1996

C. Description of monument for corner and accessories established to perpetuate locating the position of the corner:
C-10
SET 4"x 36" CONC MON W/BENZIE CO REMON PROGRAM BRASS CAP IN PLACE OF FD 1"x 33" IRON PIPE.
#11"S.MAPLE(CLP) N05°E 33.24'(REPLACED FD NAIL W/SPIKE & BCRP TAG E SIDE)
#14" B.CHERRY S58°E 24.82'(REPLACED FD NAIL W/SPIKE & BCRP TAG NE SIDE)
#12" B.CHERRY S32°E 43.47'(REPLACED FD NAIL W/SPIKE & BCRP TAG SW SIDE)
FD 1/2" REROD W/CAP #25845 WEST 65.93'
SE COR GARAGE N44°W 109.5'
CTR 32'+/- 3' WIDE N-S GRAVEL ROAD IS 16' WEST.

STATE OF MICHIGAN
CARL KIISKILA
LAND SURVEYOR
No. 33981
LICENSED LAND SURVEYOR

#= WIT BY OTHERS, ‡= PS, WM.BATZER 1975 WIT.

Signed by Carl T. Kiiskila
Surveyor's Michigan License No. 33981
Date 4-9-97

FORM APPROVED BY MICHIGAN STATE BOARD OF PROFESSIONAL SURVEYORS, JAN. 28, 1971
REVISED MAY 14,1975
REVISED JAN., 1983
REVISED OCT., 1995