

**Remonumentation corner under P.A. 345, Michigan P.A. of 1990
LAND CORNER RECORDATION CERTIFICATE
Filing Requirement of Act 74, Mich. P.A. 1970**

ALMIRA TWP.

For corners in

BENZIE
(County)

Located In: _____ Corner Code # _____

1. Public Land Survey

T 27 R 13 W _____ D5
T _____ R _____
T _____ R _____
T _____ R _____

2. Property Controlling In Section

S _____ T _____ R _____
S _____ T _____ R _____

3. Miscellaneous Property in Sec.

S _____ T _____ R _____
S _____ T _____ R _____

4. Lot No. _____, Recorded Plat _____
5. Private Claims _____

LIBER 2 PAGE 174

STATE OF MICHIGAN
BENZIE COUNTY
RECORDED

19 Jan 1998 2:51:29 PM

MICHELLE R. GRAY
REGISTER OF DEEDS

8 PAGES One
Register of Deeds Stamp & File Number

I, Matthew T. Mokanyk, in a field survey on December 29, 1997 do hereby certify that under requirements of P.A. 74, Michigan P.A. of 1970, the corner points mentioned in lines 1 and 2 above were in conformance with regulations and rules therefore as required in the current manual of survey instructions of the United States Department of the Interior, Bureau of Land Management or by a decree of a Court of Law and/or that the corner points mentioned in lines 3, 4 and 5 above were in conformance with the rules of the Michigan Board of Land Surveyors or by a Decree of a Court of Law; established, re-established, monumented, re-monumented, recovered, found as expressed below:


GC# 97480.01

NOTE: Not more than 4 corners, all in the same town and range, may be recorded on this certificate.

A. Description of original monument and accessories and/or subsequent restoration:
August 1850 - GLO Surveyor - Set Sugar for post and two accessories: N30°W - 2.6' - Sugar 20" S44°E - 1.9' - Sugar 10"
June 1978 - Harold Bruning J#78.2053 Benzie Co. Marker and three accessories: S75°W - 68.49' - Maple 14" S55°W - 52.27' - Maple 14" S45°E - 30.20' - Maple 40" Tw.

D.F. Holden - found old Brg. Trees in bad condition, set new Brg. Trees.

March 1975 (L.1, P.373) - Harold Bruning J#73-1450 - Benzie Co. Marker Set midway and on line between NW and NE corner of section 17. Three accessories: S75°W - 68.49' - Maple 14" S55°W - 52.27' - Maple 14" S45°E - 30.30' - Maple 40" Tw.

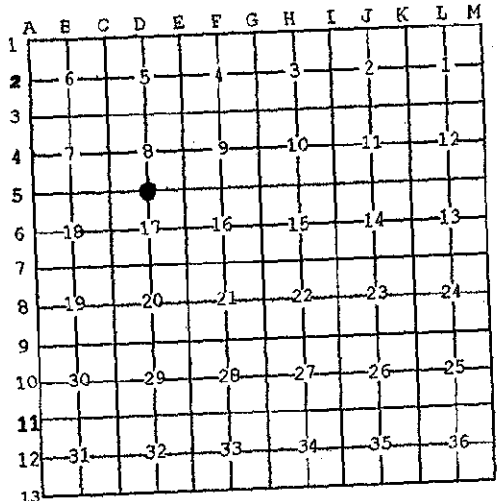

SURVEY & REMONUMENTATION

APR 07 1998

SECTION

Ratified by Peer Group
In accordance with P.A. 345
Chairman [Signature]
Date 12/18/97

B. Description of corner evidence found and/or method applied in restoring or reestablishing corner:
December 1997- Gosling Czubak Remonumentation
Found 1/2" re-bar cap #13030 ±0.5' below road surface. Also found Benzie Co. Monument ±3' below road surface. Benzie County Peer Group accepted position of Benzie Co. Monument for corner D5. Removed re-bar and Benzie Co. Monument. Set standard Benzie County Remonumentation Monument.

C. Description of monument for corner and accessories established to perpetuate locating the position of the corner:
December 1997- Gosling Czubak Remonumentation
D5 (corner to sections 8 and 17, T27N-R13W, Almira Twp.)
Set standard Benzie County Remonumentation Monument:
S57W 62.35' to spike in N face 18" Maple
S77W 68.5' to C.L. 18" Maple (found old blaze)
N55W 85.33' to spike in NE face 30" Maple
N50E 54.71' to spike in SE face 10" R. Pine
S63E 77.49' to spike in N face 22" Maple

Signed by Matthew T. Mokanyk Date 12-30-97
Surveyor's Michigan License No. 42063

