

MAR 09 2000

SECTION

LAND CORNER RECORDATION CERTIFICATE  
Filing Requirement of Act 74, Mich. P.A. 1970 LIBER 2 PAGE 316

For corners in Almira Township

BENZIE Located In: \_\_\_\_\_ Corner Code # \_\_\_\_\_  
(County)

1. Public Land Survey T27N R13W D-9  
T\_\_\_\_ R\_\_\_\_  
T\_\_\_\_ R\_\_\_\_

2. Property Controlling S\_\_\_\_ T\_\_\_\_ R\_\_\_\_  
in Section S\_\_\_\_ T\_\_\_\_ R\_\_\_\_

3. Miscellaneous S\_\_\_\_ T\_\_\_\_ R\_\_\_\_  
Property in Sec. S\_\_\_\_ T\_\_\_\_ R\_\_\_\_

4. Lot No. \_\_\_\_\_, Recorded Plat \_\_\_\_\_

5. Private Claims \_\_\_\_\_

STATE OF MICHIGAN  
BENZIE COUNTY  
RECORDED

4 FEB 2000 1:08:24 PM  
MICHELLE R. GRAY  
REGISTER OF DEEDS  
# PAGES one

Register of Deeds Stamp & File Number

I, JOHN F. KORR JR., in a field survey on November 29, 1999 do hereby certify that under requirements of P.A. 74, Michigan P.A. of 1970, the corner points mentioned in lines 1 and 2 above were in conformance with regulations and rules therefore as required in the current manual of survey instructions of the United States Department of the Interior, Bureau of Land Management or by a decree of a Court of Law and/or that the corner points mentioned in lines 3, 4 and 5 above were in conformance with the rules of the Michigan Board of Land Surveyors or by a Decree of a Court of Law; established, re-established, monumented, re-monumented, recovered, found as expressed below:

**NOTE: Not more than 4 corners, all in the same town and range, may be recorded on this certificate.**

A. Description of original monument and accessories and/or subsequent restoration:

1850 GLO - Survey - Set post for corner with two witnesses:  
Hemlock 6" - N03°W - 4.62'; Hemlock 12" - S60°W - 10.56'.

Benzie Co. Road County Road Commission - Draft L.C.R.C. No/Date & No corner information.

1901 Benzie Co. Survey records, Liber 1, Page 16, No corner I.D. for survey in N.W. 1/4, Section 29.

1975 - Wm. Batzer, Certificate of Survey, Liber 1, Page 415, No corner mentioned on a Section Break.

1976 - Wm. Batzer, Certificate of Survey, Liber 1, Page 519, No corner mentioned.

1991 - Neil Livasy - Certificate of Survey, recorded in Liber 2, Page 190; found 1/2" rebar; witnessed by: Tw. Maple 18" - S16°E - 39.75'; P.Pole - N70°W - 163.98'; 1/2" rerod 33.00' to the North & South.

1999 - Max Harris - Certificate of Survey - recorded in Liber. 2, Page 1129 & No corner I.D. & No witnesses, Section data the same as Batzer.

1999 - Max Harris - Certificate of Survey - recorded in Liber. 2, Page 1186, 1/2" iron found, witnessed, the same as Livasy survey of 1991 above.


B. Description of corner evidence found and/or method applied in restoring or reestablishing corner:

1999 GCES - D-9 found 1/2" rebar as called for in the Harris & Livasy surveys in section A, above 2.5' North of centerline for Fogg Road. I accepted this position as a locally accepted corner.

C. Description of monument for corner and accessories established to perpetuate locating the position of the corner:

At the position of D-9, I set a Standard Benzie Co. Remonumentation Monument, witnessed by the following:

- Tw. Maple 10" - S10°E - 39.75' - found spike
- P.Pole - N65°W - 164.05' - found spike
- 1/2" rerod 33.03' to the North, P.S. No. 22434
- 1/2" rerod 33.00' to the South, P.S. No. 24585
- Poplar 12" - S45°E - 59.11 - set spike
- Fence line running North

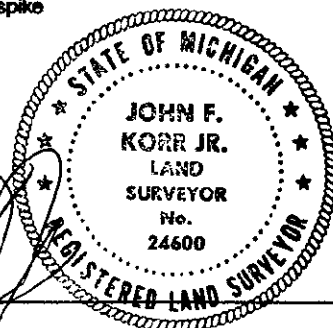

Ratified by Peer Group  
In accordance with P.A. 345  
Chairman [Signature]  
Date 11/13/1999

Signed by [Signature]  
John F. Korrr, Jr.  
Surveyor's Michigan License No. 24600

Date 12/23/99

	A	B	C	D	E	F	G	H	I	J	K	L	M
1													
2		6		5		4		3		2		1	
3													
4		7		8		9		10		11		12	
5													
6		18		17		16		15		14		13	
7													
8		19		20		21		22		23		24	
9				●									
10		30		29		28		27		26		25	
11													
12		31		32		33		34		35		36	
13													