

JUL 23 1999

SECTION

LAND CORNER RECORDATION CERTIFICATE
Filing Requirement of Act 74, Mich. P.A. 1970

LIBER 2 PAGE 181

For corners in Almira Township

<u>BENZIE</u> (County)	Located In:	Corner Code #
1. Public Land Survey	T <u>27</u> N R <u>13</u> W	<u>F-9</u>
	T _____ R _____	_____
	T _____ R _____	_____
2. Property Controlling in Section	S _____ T _____ R _____	_____
	S _____ T _____ R _____	_____
3. Miscellaneous Property in Sec.	S _____ T _____ R _____	_____
	S _____ T _____ R _____	_____
4. Lot No. _____, Recorded Plat _____		
5. Private Claims _____		

STATE OF MICHIGAN
BENZIE COUNTY
RECORDED

7 JAN 1999 4:05:24 PM
MICHELLE R. GRAY
REGISTER OF DEEDS
PAGES ONE

Register of Deeds Stamp & File Number

I, JOHN F. KORR, JR., in a field survey on December 11, 19 98, do hereby certify that under requirements of P.A. 74, Michigan P.A. of 1970, the corner points mentioned in lines 1 and 2 above were in conformance with regulations and rules therefore as required in the current manual of survey instructions of the United States Department of the Interior, Bureau of Land Management or by a decree of a Court of Law and/or that the corner points mentioned in lines 3, 4 and 5 above were in conformance with the rules of the Michigan Board of Land Surveyors or by a Decree of a Court of Law; established, re-established, monumented, re-monumented, recovered, found as expressed below:

NOTE: Not more than 4 corners, all in the same town and range, may be recorded on this certificate.

A. Description of original monument and accessories and/or subsequent restoration:

July 1850 GLO - Survey - Set post for corner with two witnesses: S32°W - 11.22' - Ironwood 6"; N58°E - 21.78' - Aspen 8".

1877 D.F. Holden re-set. Post from Original B.T.

1977 Carl Roser - during a preliminary section retracement found 1" iron pipe in road and iron 33 feet South, Lic. No. 9189.

June 1978 (survey in Sec. 21, L. 1, P. 611) - Wm. B. Batzer J # 7851, found a 3/4" iron pipe in concrete, Witnesses: South - 39.91' - Maple 10"; S36°E - 48.84' - W. Pine 12"; N6°E - 59.69' - Power Pole; N68°W - 61.53' - 14" W. Pine.

December 1979 - Survey by Corey J. Hughes J # 79547, found a 1" iron pipe in with large rock along side, Witnesses: South - 39.90' - Maple 10"; S35°E - 48.85' - W. Pine 12"; N68°W - 61.55' - 12" W. Pine.

January 1990 - Max Harris, (LCRC, L. 1, P. 258), found 3/4" iron pipe in centerline East-West road & woods line South. Witnessed by: Triple 6" Cherry - S64°W - 63.20'; 14" W. Pine - N65°W - 61.45'; 10" Maple - S2°W - 39.65'; Power Pole - N04°E - 59.70'.


B. Description of corner evidence found and/or method applied in restoring or reestablishing corner:

December 1998 - I found the 1" iron pipe and a large 15" x 8" x 12" stone along side on the South side, found by all in section A. above, and all 4 of the Harris Witnesses were found in place. Accepted this iron pipe as the best available evidence as a local accepted corner.

C. Description of monument for corner and accessories established to perpetuate locating the position of the corner:

At the position of F-9, I set a Standard Benzie Co. Remonumentation Monument, witnessed by the following:
Triple 6" Cherry - S64°W - 63.24'
14" W. Pine - N65°W - 61.46'
10" Maple - S2°W - 39.63'
Power Pole - N04°E - 59.71'.

	A	B	C	D	E	F	G	H	I	J	K	L	M
1													
2	6		5		4		3		2		1		
3													
4	7		8		9		10		11		12		
5													
6	18		17		16		15		14		13		
7													
8	19		20		21		22		23		24		
9													
10	30		29		28		27		26		25		
11													
12	31		32		33		34		35		36		
13													

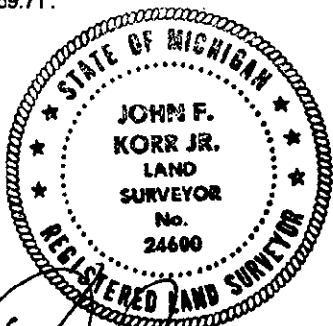

Ratified by Peer Group
In accordance with R.A. 845
Chairman [Signature]
Date 11/24/98

Signed by [Signature] Date 12/29/98
John F. Korrr, Jr.
Surveyor's Michigan License No. 24600