

APR 14 1998

LAND CORNER RECORDATION CERTIFICATE
Filing Requirement of Act 74, Mich. P.A. 1970

STATE OF MICHIGAN
BENZIE COUNTY
RECORDED

For corner SECTION

Benzie
(County)

Located In: Corner Code #

- 1. Public Land Survey T 27N R 13W I-6
2. Property Controlling in Section S T R
3. Miscellaneous S T R
4. Lot No. Recorded Plat
5. Private Claims

19 Jan 1998 9:32:32 AM
MICHELLE R. GRAY
REGISTER OF DEEDS
PAGES ONE

Register of Deeds Stamp & File Number

I, John B. Smendzuik, in a field survey on December 20, 1997, do hereby certify that under requirements of P.A. 74, Michigan P.A. of 1970, the corner points mentioned in lines 1 and 2 above were in conformance with regulations and rules therefore as required in the current manual of survey instructions of the United States Department of the Interior, Bureau of Land Management or by a decree of a Court of Law and/or that the corner points mentioned in lines 3, 4 and 5 above were in conformance with the rules of the Michigan Board of Land Surveyors or by a Decree of a Court of Law; established, re-established, monumented, re-monumented, recovered, found as expressed below:

Grid table with columns A-M and rows 2-13. A dot is marked at the intersection of column I and row 6.

NOTE: Not more than 4 corners, all in the same town and range, may be recorded on this certificate.


A. Description of original monument and accessories and/or subsequent restoration: I-6: 1850: GLO set Hemlock post for corner - Beech 12" S62°W 35 links and Hemlock 16" N13°E 8 links. Undated: James A. Pettit, Surveyor's Record 2, Page 20, set cedar post 6' in diameter equidistant between section corners. 1963: Harold R. Bruning in Old section corner record, Page 48, says the corner is in an area of 4 to 6' of road fill, said because of old sectional break info from Pettit which fits fences at that time, he reset the corner from the north and south and east-west fences. Bruning set a 4" diameter concrete monument with Benzie County cap at corner. Undated: BCRC found concrete monument and witnessed it. 1977: Gourdie Fraser and Associates, set PK nail from BCRC witnesses. 1979: Bill Batzer found PK nail and BCRC witnesses. 1995: John B. Smendzuik found a rebar with cap of GFA #13030 in centerline of road which fits remaining Batzer and Bruning witnesses.

B. Description of corner evidence found and/or method applied in restoring or reestablishing corner: I-6: 1997: Found rebar with cap GFA #13030 at road surface over a 3" in diameter concrete monument with a Benzie County Cap 22" below grade. The Benzie County Peer Group accepted the rebar as the perpetuation of the obliterated GLO corner.

Ratified by Peer Group
In accordance with P.A. 345
Chairman [Signature]
Date 12/12/95

C. Description of monument for corner and accessories established to perpetuate locating the position of the corner: I-6: Pulled the rebar and concrete monument and set a 3" diameter Benzie County Remonumentation Program concrete monument with a brass cap in a monument box.

- Power Pole S30°W 65.04 to set BCRP tag and nail.
24" W. Pine N64°E 135.03 to set BCRP tag and nail. (Bruning witness)
15" W. Pine S70°E 67.27' found 60D spike grown over and set BCRP tag and nail.
16" W. Pine N67°E 118.83' to set BCRP tag and nail.
Monument box is in centerline of Reynolds Road.

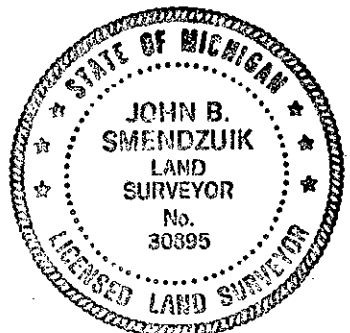

Signed by [Signature] Date 1/18/98
Surveyor's Michigan License No. 30895