

LAND CORNER RECORDATION CERTIFICATE
Filing Requirement of Act 74, Mich. P.A. 1970

For corners in

| | | |
|--|---------------------------|---------------|
| <u>Benzie</u> <small>(County)</small> | Located In: | Corner Code # |
| 1. Public Land Survey | T <u>27N</u> R <u>14W</u> | <u>C - 9</u> |
| | T _____ R _____ | _____ |
| | T _____ R _____ | _____ |
| 2. Property Controlling in Section | S _____ T _____ R _____ | _____ |
| | S _____ T _____ R _____ | _____ |
| 3. Miscellaneous Property in Sec. | S _____ T _____ R _____ | _____ |
| | S _____ T _____ R _____ | _____ |

Register of Deeds Stamp & File Num.

4. Lot No. _____, Recorded Plat _____

5. Private Claims _____

I, Craig W. McVean, in a field survey on Sept. 21, 19 98 do hereby state that under requirements of P.A. 74, Michigan P.A. of 1970, the corner points mentioned in lines 1 and 2 above were in conformance with regulations and rules therefore as required in the current manual of survey instructions of the United States Department of the Interior, Bureau of Land Management or by a decree of a Court of Law and for that the corner points mentioned in lines 3, 4 and 5 above were in conformance with the rules of the Michigan Board of Land Surveyors or by a Decree of a Court of Law; established, re-established, monumented, recovered, found as expressed below:

| | | | | | | | | | | | | |
|----|----|----|----|----|----|----|---|---|---|---|---|---|
| A | B | C | D | E | F | G | H | I | J | K | L | M |
| 1 | | | | | | | | | | | | |
| 2 | 6 | 5 | 4 | 3 | 2 | 1 | | | | | | |
| 3 | | | | | | | | | | | | |
| 4 | 7 | 8 | 9 | 10 | 11 | 12 | | | | | | |
| 5 | | | | | | | | | | | | |
| 6 | 18 | 17 | 16 | 15 | 14 | 13 | | | | | | |
| 7 | | | | | | | | | | | | |
| 8 | 19 | 20 | 21 | 22 | 23 | 24 | | | | | | |
| 9 | | | | | | | | | | | | |
| 10 | 30 | 29 | 28 | 27 | 26 | 25 | | | | | | |
| 11 | | | | | | | | | | | | |
| 12 | 31 | 32 | 33 | 34 | 35 | 36 | | | | | | |
| 13 | | | | | | | | | | | | |

NOTE: Not more than 2 corners, all in the same town and range, may be recorded on this certificate.

A. Description of original monument and accessories and/or subsequent restoration:


- C-9 - GLO - Set Section Post - J. Hunt - 1850
North corrected between sec's 30 & 29,
from corner of sec's 29-30-31-32, 79.44
Beech 26" N49°W (no distance given)
Beech 14" S11°E (no distance given)
- Li. 1, Pgs. 150 151 - F. Haswell - 1895
Survey of S-19, T27N R14W
'E' set from sight tree East 628 links, where
line crosses line from Beech 26" N49°W,
no distance. Planted Hem. Stake 3 ft. deep
and filled hole with black dirt and planted
bottle in bottom of hole.
- Co. Surveyor Bk. - Pgs. 196 & 197 - J.A. Pettitt - 1897
Survey of S-20, T27N R14W
"From NW corner South var 20' W at 79.71,
intersected 21 lks East of SW Corner."
- Co. Surveyor Bk. - Record 2, Pgs. 68 & 69 - F. S. Haswell - 1907
Survey of S-30, T27N R14W at position "2" states
"Cedar Post Planted in center of highway see Record 1, Pgs. 150 - 151"
- Co. Surveyor Bk. - Rec. 2, Pgs. 90 & 91 - F.S. Haswell - 1909
Survey of S-29, T27N R14W at position "1" states
"Cedar Post planted 5 ft deep from the original
witness tress, see old record page 150."
- Rec. Sur. - Li. 1, Pages 140 & 141 - Wm. B. Batzer Jr. - 1972
Set 1/2" x 4" iron rod
Chiseled "x" in top of 24" Ø con. tile N42°E 70.58'
Top guard rail post S31°W 38.47'
Stop sign S88°W 37.60'
- LCRC - Li. 1, Page 106 - H.R. Bruning - 1974
Found 1/2" x 4" iron rod
Same witnesses as Batzer Rec. Sur.

B. Description of corner evidence found and/or method applied in restoring or reestablishing corner:

C - 9 - Corner common to Sec.'s 19, 20, 29, and 30. FND. 1/2" x 4" Iron w/ 3/4" x 1" head, as set by Batzer. Center of N-S bit road is 1' West. Center of gravel road West is 15' ± North. Excavated 3' dia. hole under Iron - dug down 8' looking for evidence of Haswell's perpetuation, nothing found - area of deep fill - up to 20' ± in SW Quad. Iron fits Haswell's distances N, S, E & W reasonably close. 1/2" Iron accepted as the best available evidence of the position of the original corner.

C. Description of monument for corner and accessories established to perpetuate locating the position of the corner:

- C-9 - Replaced found Iron with Benzie Co. Concrete Monument in Mon. Box
Found PK nail in 4" x 4" wolmanized post by metal Tel. Riser N33°W 61.84'
Found PK nail in SE side of Power Pole N56°E 57.47'
Found PK nail in top 6" x 8" wolmanized wood guard rail post S56°W 28.62'
Found PK nail in South side Cedar gate post N80°E 27.67'
Found old stop sign post S88°W 37.6' (HB)

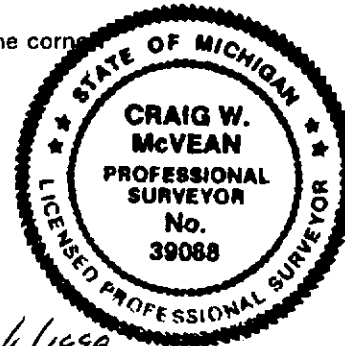

Signed by Craig W. McVean
 Surveyor's Michigan License No. 39088

Date 10/6/1998