

LAND CORNER RECORDATION CERTIFICATE
Filing Requirement of Act 74, Mich. P.A. 1970

For corners in

| | | |
|------------------------------------|---------------------------------------|---------------|
| <u>BENZIE</u> (County) | Located In: | Corner Code # |
| 1. Public Land Survey | T <u>27N</u> R <u>14W</u> | <u>D12</u> |
| — | T _____ R _____ | _____ |
| 2. Property Controlling in Section | S <u>32</u> T <u>27N</u> R <u>14W</u> | <u>8</u> |
| — | S _____ T _____ R _____ | _____ |
| 3. Miscellaneous Property in Sec. | S _____ T _____ R _____ | _____ |
| — | S _____ T _____ R _____ | _____ |

Register of Deeds Stamp & File Number

4. Lot No. _____, Recorded Plat _____

5. Private Claims _____

I, Craig W. McVean, in a field survey on MAY 6, 1997 do hereby state that under requirements of P.A. 74, Michigan P.A. of 1970, the corner points mentioned in lines 1 and 2 above were in conformance with regulations and rules therefore as required in the current manual of survey instructions of the United States Department of the Interior, Bureau of Land Management or by a decree of a Court of Law and for that the corner points mentioned in lines 3, 4 and 5 above were in conformance with the rules of the Michigan Board of Land Surveyors or by a Decree of a Court of Law; established, re-established, monumented, recovered, found as expressed below:

| | | | | | | | | | | | | |
|----|----|----|----|----|----|----|---|---|---|---|---|---|
| A | B | C | D | E | F | G | H | I | J | K | L | M |
| 1 | | | | | | | | | | | | |
| 2 | 6 | 5 | 4 | 3 | 2 | 1 | | | | | | |
| 3 | | | | | | | | | | | | |
| 4 | 7 | 8 | 9 | 10 | 11 | 12 | | | | | | |
| 5 | | | | | | | | | | | | |
| 6 | 18 | 17 | 16 | 15 | 14 | 13 | | | | | | |
| 7 | | | | | | | | | | | | |
| 8 | 19 | 20 | 21 | 22 | 23 | 24 | | | | | | |
| 9 | | | | | | | | | | | | |
| 10 | 30 | 29 | 28 | 27 | 26 | 25 | | | | | | |
| 11 | | | | | | | | | | | | |
| 12 | 31 | 32 | 33 | 34 | 35 | 36 | | | | | | |
| 13 | | | | | | | | | | | | |

NOTE: Not more than 2 corners, all in the same town and range, may be recorded on this certificate.

A. Description of original monument and accessories and/or subsequent restoration:

D12 Unrecorded survey-Sec. 32-Gourdie-Fraser & Assoc. #76891 Set iron-G. Delamater-1977 8 Unrecorded survey-Sec. 32-Gourdie-Fraser & Assoc. #76891 Set iron-G. Delamater-1977

B. Description of corner evidence found and/or method applied in restoring or reestablishing corner:


D12 -Center 1/4 Sec. 32- Set 2" A.C. on 5/8"x 34" rebar in ring of stone w/ carsonite guard post at intersection of 1/4 lines. Old E-W fence remains 11' +/- N.
Ref. Pt.-Fnd. GFA cap iron S89° 53'E 26.64'. Monument not accepted due to rejected N 1/4 cor. of Sec. 32 by GFA.

8 C W 1/16 Sec. 32-Set 2" A.C. on 5/8" x 34" Rebar w/ blue carsonite guard post per Standard BLM procedure. FND OLD E-W B/WIRE FENCE REMAINS CEDAR POSTS ON GROUND 14' +/- 2' N. CENTER 15' TO 17' WIDE OPENING TO W. IN HARDWOODS 18' +/- N. POSSIBLE OLD WAGON TRAIL OR ROAD.
Ref. Pt.- Fnd. GFA cap iron N 89° 16'E 13.52'. Monument not accepted due to rejected N 1/4 of Sec. 32 by GFA.

C. Description of monument for corner and accessories established to perpetuate locating the position of the corner:

D12-BUILT RING OF ROCKS AROUND SET 5/8" X 34" REROD W/ 2" DIAMETER ALUM CAP. SET CARSONITE POST W/ LOC. TAG
 21" SUGAR MAPLE N 62° W 35.59'
 15" SUGAR MAPLE N 14° W 25.31'
 22" TRIPLE SUGAR MAPLE N 24° E 33.22'
 9" ASPEN S 35° E 10.39'

8 SET 5/8" REROD W/2" DIA. ALUM CAP W/POST
 5" SUGAR MAPLE N 40° W 25.59'
 7" SUGAR MAPLE N 47° E 28.04'
 8" SUGAR MAPLE N 61° E 13.77'
 12" MAPLE IN CLUMP 5 S 40° E 18.87'

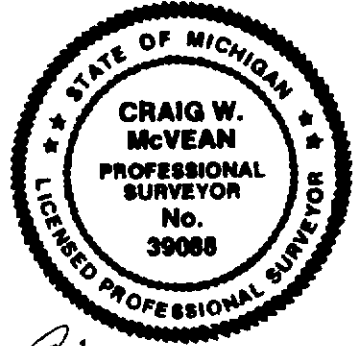

Signed by Craig W. McVean Date 9/29/1998

Surveyor's Michigan License No. 39088