


LAND CORNER RECORDATION CERTIFICATE
Filing Requirement of Act 74, Mich. P.A. 1970

For corners in

<u>BENZIE</u> <small>(County)</small>	Located In:	Corner Code #
1. Public Land Survey	T <u>27N</u> R <u>14W</u> T _____ R _____	<u>F12</u>
2. Property Controlling in Section	S <u>33</u> T <u>27N</u> R <u>14W</u> S _____ T _____ R _____	<u>11</u>
3. Miscellaneous Property in Sec.	S _____ T _____ R _____ S _____ T _____ R _____	_____
4. Lot No. _____, Recorded Plat _____		
5. Private Claims _____		

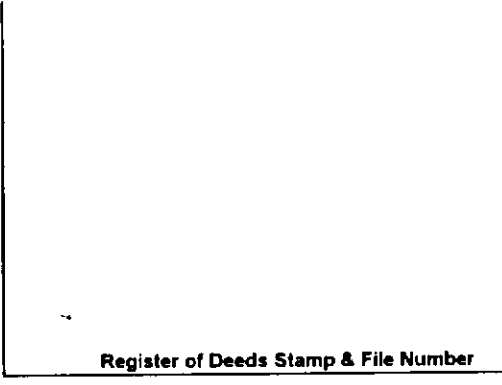

I, Craig W. McVean, in a field survey on JULY 1996 do hereby state that under requirements of P.A. 74, Michigan P.A. of 1970, the corner points mentioned in lines 1 and 2 above were in conformance with regulations and rules therefore as required in the current manual of survey instructions of the United States Department of the Interior, Bureau of Land Management or by a decree of a Court of Law and for that the corner points mentioned in lines 3, 4 and 5 above were in conformance with the rules of the Michigan Board of Land Surveyors or by a Decree of a Court of Law; established, re-established, monumented, recovered, found as expressed below:

NOTE: Not more than 2 corners, all in the same town and range, may be recorded on this certificate.

A	B	C	D	E	F	G	H	I	J	K	L	M
1												
2	6	5	4	3	2	1						
3												
4	7	8	9	10	11	12						
5												
6	18	17	16	15	14	13						
7												
8	19	20	21	22	23	24						
9												
10	30	29	28	27	26	25						
11												
12	31	32	33	34	35	36						
13												

A. Description of original monument and accessories and/or subsequent restoration:

F12-CO. SUR.-G. LANGFORD-IRON 6 X 1.5 FT. LONG-NO DATE 11 NONE



B. Description of corner evidence found and/or method applied in restoring or reestablishing corner:

F12 FOUND A PLOW POINT FOR THE CENTER OF SEC. 33 IN APPROXIMATELY THE CENTER OF N-S GRAVEL ROAD. THE CORNER FITS OLD CO. SUR. SUB'D OF S-33 NOTES. OLD FENCE REMAINS N-S-E IS 18'E. OLD FENCE REMAINS N-S-W 31'W. ACCEPT PLOW POINT AS LANGFORD'S MONUMENT FOR CENTER OF SEC. 33.

11- ESTABLISHED THE CENTER OF S.W. 1/4 OF SEC. 33 AS PER STANDARD BLM INSTRUCTIONS. THE CORNER FALLS IN REMAINS OF A N-S B/WIRE FENCE. THE CENTER OF A 2-TRACK S.E. & N.W. IS 130' SOUTH.

C. Description of monument for corner and accessories established to perpetuate locating the position of the corner:

F12 FOUND PLOW POINT AND ADDED A 2" X 3" T IRON 1' LONG WITH FOOT ON BOTTOM ALONG E. SIDE.
 3" SUGAR MAPLE N 60° W 22.62'
 4" SUGAR MAPLE N 70° E 48.08'
 14" R. PINE S 50° E 47.89'
 3" SUGAR MAPLE S 85° W 30.55'
 SET CARSONITE POST W/LOC TAG WEST 31'

11 SET 5/8" X 34" REROD W/PS CAP AND CARSONITE POST W/LOC TAG.
 2" IRONWOOD N 40° W 15.8'
 2" BEECH N 40° E 12.9'
 9" SUGAR MAPLE S 25° E 13.4'
 2" BEECH S 45° W 8.4'

Signed by Craig W. McVean
 Surveyor's Michigan License No. 39088

Date 08/27/97