

LAND CORNER RECORDATION CERTIFICATE
Filing Requirement of Act 74, Mich. P.A. 1970

For corners in


<u>Benzie</u> <small>(County)</small>	Located In:	Corner Code #
1. Public Land Survey	T ___ R ___	_____
	T ___ R ___	_____
	T ___ R ___	_____
2. Property Controlling in Section	S <u>28</u> T <u>27N</u> R <u>14W</u>	<u>4</u>
	S <u>28</u> T <u>27N</u> R <u>14W</u>	<u>3</u>
3. Miscellaneous Property in Sec.	S ___ T ___ R ___	_____
	S ___ T ___ R ___	_____

Register of Deeds Stamp & File Number

4. Lot No. _____, Recorded Plat _____

5. Private Claims _____

I, Carl Kiiskila, in a field survey on July 19 96 do hereby state that under requirements of P.A. 74, Michigan P.A. of 1970, the corner points mentioned in lines 1 and 2 above were in conformance with regulations and rules therefore as required in the current manual of survey instructions of the United States Department of the Interior, Bureau of Land Management or by a decree of a Court of Law and for that the corner points mentioned in lines 3, 4 and 5 above were in conformance with the rules of the Michigan Board of Land Surveyors or by a Decree of a Court of Law; established, re-established, monumented, recovered, found as expressed below:

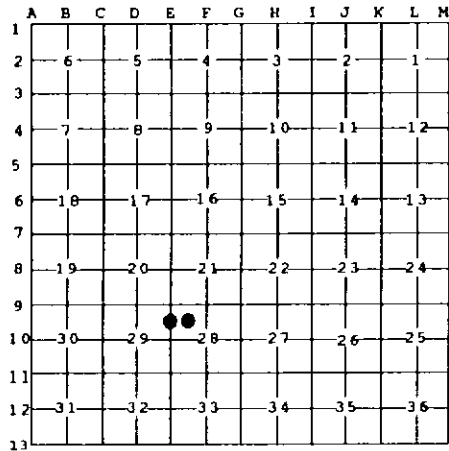

NOTE: Not more than 2 corners, all in the same town and range, may be recorded on this certificate.

A. Description of original monument and accessories and/or subsequent restoration:

4 - None 3 - None

B. Description of corner evidence found and/or method applied in restoring or reestablishing corner:

<u>4</u> - NW 1/16 Sec. 28 - Set 5/8" x 34" Rebar with PS cap with carsonite Guard Post per standard BLM procedure.	<u>3</u> - N 1/16 Sec. 28 & 29 - Set 5/8" x 34" Rebar with PS cap with carsonite guard Post per standard BLM Procedure.
---	---

C. Description of monument for corner and accessories established to perpetuate locating the position of the corner:

<u>4</u> - Mon. per Part 'B' 10" S. Maple Clump S38°W 34.9' 11" S. Maple S22°E 57.9' 8" S. Maple Clump S62°E 71.4' FND. 3/4" pipe & 1 1/2" Axle shaft guard S3°27'E 24.79'	<u>3</u> - Mon. per Part 'B' Ctr. Bit Rd. N56°W 123' Ctr Driveway S45°W 38' 5" B. Cherry N40°W 11.88' 2" Maple N28°E 21.55' 6" W. Birch S10°W 16.27' 10' S. Pine S70°W 5.29'
---	--



Signed by Carl T. Kiiskila
 Surveyor's Michigan License No. 33981

Date 9-17-98