

LAND CORNER RECORDATION CERTIFICATE
Filing Requirement of Act 74, Mich. P.A. 1970


For corners in

<u>Benzie</u> <small>(County)</small>	Located In:	Corner Code #
1. Public Land Survey	T ___ R ___	_____
	T ___ R ___	_____
	T ___ R ___	_____
2. Property Controlling in Section	S 28 T 27N R 14W	<u>2</u>
	S 28 T 27N R 14W	<u>7</u>
3. Miscellaneous Property in Sec.	S ___ T ___ R ___	_____
	S ___ T ___ R ___	_____

Register of Deeds Stamp & File Num.

4. Lot No. _____, Recorded Plat _____

5. Private Claims _____

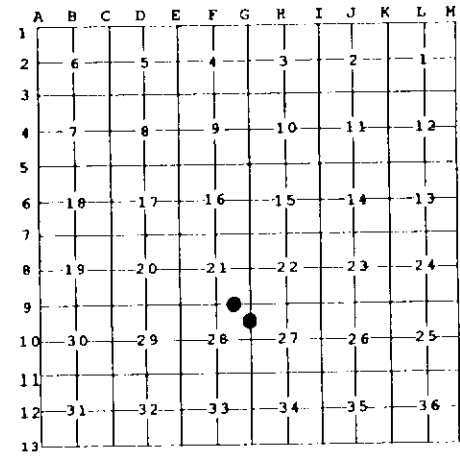

I, Carl Kiiskila, in a field survey on July 19 96 do hereby state that under requirements of P.A. 74, Michigan P.A. of 1970, the corner points mentioned in lines 1 and 2 above were in conformance with regulations and rules therefore as required in the current manual of survey instructions of the United States Department of the Interior, Bureau of Land Management or by a decree of a Court of Law and/or that the corner points mentioned in lines 3, 4 and 5 above were in conformance with the rules of the Michigan Board of Land Surveyors or by a Decree of a Court of Law; established, re-established, monumented, recovered, found as expressed below:

NOTE: Not more than 2 corners, all in the same town and range, may be recorded on this certificate.

A. Description of original monument and accessories and/or subsequent restoration:

2 - R.M. Harris - Job #83-2-331
Set Iron Rod - 1991

7 - None.

B. Description of corner evidence found and/or method applied in restoring or reestablishing corner:

2 - E 1/16 Sec. 21 & 28 - FND. PS Cap #25845 on 1/2" Rerod. Fits calculated BLM Procedure within reason and is accepted as the best available evidence of corner.

7 - N 1/16 Sec. 27 & 28 - Set 5/8" x 34" Rebar w/PS Cap with Carsonite Guard Post per standard BLM Procedure.


C. Description of monument for corner and accessories established to perpetuate locating the position of the corner:

2 - Capped Iron rerod- Added Blue Carsonite Guard Post.

15" Beech N10° W 39.03'
5" Twin S. Maple N20°E 24.57'
13" Twin W. Ash S45° E 40.67'
5" S. Maple S60° W 13.20'

7 - Monument per Part B.

8" S. Maple N48°E 17.13'
33" Triple R. Maple S45° E 9.47'
8" Beech S38° W 10.82'
11" S. Maple N64° W 10.93'

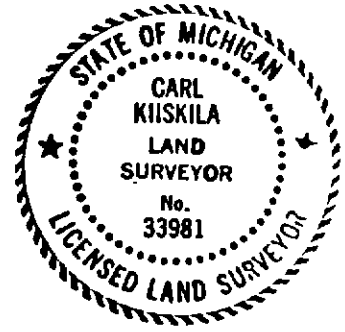

Signed by Carl T. Kiiskila Date 9-17-98
 Surveyor's Michigan License No. 33981