LAND CORNER RECORDATION CERTIFICATE
Filing Requirement of Act 74, Mich. P.A. 1970

For corners in

BENZIE
(County)

	Located In:		Corner Code #
1. Public Land Survey		T 27N R 14W	K-13, L-13
		T___ R___	
		T___ R___	
		T___ R___	
2. Property Controlling	S___	T___ R___	
In Section	S___	T___ R___	
3. Miscellaneous	S___	T___ R___	
Property in Sec.	S___	T___ R___	

Register of Deeds Stamp & File Number

4. Lot No. _____ , Recorded Plat _____
5. Private Claims _____

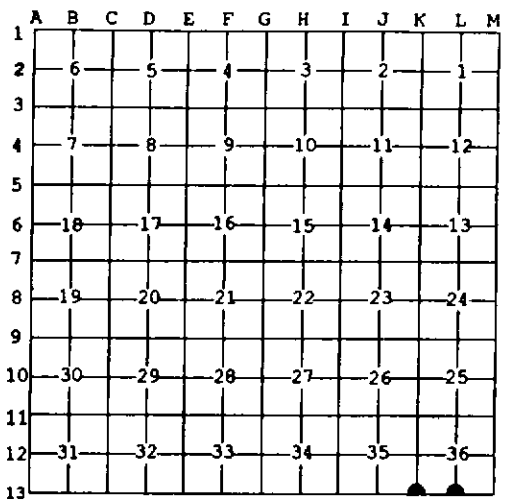

I, CARL T. KIISKILA, in a field survey on JUNE 6, 19 96 do hereby state that under requirements of P.A. 74, Michigan P.A. of 1970, the corner points mentioned in lines 1 and 2 above were in conformance with regulations and rules therefore as required in the current manual of survey instructions of the United States Department of the Interior, Bureau of Land Management or by a decree of a Court of Law and /or that the corner points mentioned in lines 3, 4 and 5 above were in conformance with the rules of the Michigan Board of Land Surveyors or by a Decree of a Court of Law; established, re-established, monumented, recovered, found as expressed below:

NOTE: Not more than 2 corners, all in the same town and range, may be recorded on this certificate.

A. Description of original monument and accessories and/or subsequent restoration:

K-13
U.S. G.L.O. - SET POST COR SEC'S 35 & 36; BEECH 9 N67°E 5, BIRCH 15 N49°W 39. NO SIGN OF G.L.O. POST OR WIT'S.

L-13
U.S. G.L.O. - SET QR. SECTION POST; SUGAR 8 N70°E 20, SUGAR 14 N71°W 33. NO SIGN OF GLO POST OR WIT'S.

B. Description of corner evidence found and/or method applied in restoring or reestablishing corner:

K-13
REESTABLISHED THE SW COR S-36 DOUBLE DOWN FOUND SEC COR 1-MILE NORTH AND FN LINE WEST, 1/2 MILE NORTH AND MIDWAY BETWEEN FD SEC COR 1-MILE N & REESTAB. 4-TWP COR 1-MILE EAST. CTR OF N-S WINDING SAND RD IS 8' WEST.

L-13
REESTABLISHED THE S1/4 COR S-36 MIDWAY AND ON LINE BETWEEN REESTABLISHED 4-TWP COR TO EAST AND REESTABLISHED SW COR S-36 TO WEST.

STATE OF MICHIGAN
CARL KIISKILA
LAND SURVEYOR
No. 33981
LICENSED LAND SURVEYOR

C. Description of monument for corner and accessories established to perpetuate locating the position of the corner:

K-13
SET 1"x 48" GALV. PIPE W/PS CAP (BURRIED 8").

5"S.MAPLE	N70°W	39.00'
27"TW.S.MAPLE	NORTH	26.59'
15"TRI.R.MAPLE	S46°E	9.03'

NW COR S-1, T26N-R14W, SET DNR MON. S88°59'36"E 21.10'

L-13
SET DNR MON & CARSONITE POST.

3"S.MAPLE	N20°W	7.74'
4"S.MAPLE	N25°E	13.09'
8"S.MAPLE	N55°E	25.05'
7"TW.S.MAPLE	S10°E	8.59'

N1/4 COR S-1, T26N-R14W, SET DNR MON S89°00'E 10.55'

Signed by Carl T. Kiiskila Date 4-9-97

Surveyor's Michigan License No. 33981

FORM APPROVED BY MICHIGAN STATE BOARD OF PROFESSIONAL SURVEYORS, JAN. 28, 1971
REVISED MAY 14, 1975
REVISED JAN., 1983
REVISED OCT., 1995