

LAND CORNER RECORDATION CERTIFICATE
Filing Requirement of Act 74, Mich. P.A. 1970

For corners in

BENZIE

(County)

Located In:

Corner Code #

1. Public Land Survey

T 27N R 14W

J-11

T _____ R _____

T _____ R _____

T _____ R _____

2. Property Controlling
In Section

S _____ T _____ R _____

S _____ T _____ R _____

3. Miscellaneous
Property in Sec.

S _____ T _____ R _____

S _____ T _____ R _____

Register of Deeds Stamp & File Number

4. Lot No. _____, Recorded Plat _____

5. Private Claims _____

I, CARL KIISKILA, in a field survey on SEPTEMBER 9, 1996 do hereby state that under requirements of P.A. 74, Michigan P.A. of 1970, the corner points mentioned in lines 1 and 2 above were in conformance with regulations and rules therefore as required in the current manual of survey instructions of the United States Department of the Interior, Bureau of Land Management or by a decree of a Court of Law and /or that the corner points mentioned in lines 3, 4 and 5 above were in conformance with the rules of the Michigan Board of Land Surveyors or by a Decree of a Court of Law; established, re-established, monumented, recovered, found as expressed below:

NOTE: Not more than 2 corners, all in the same town and range, may be recorded on this certificate.

	A	B	C	D	E	F	G	H	I	J	K	L	M
1													
2		6		5		4		3		2		1	
3													
4		7		8		9		10		11		12	
5													
6		18		17		16		15		14		13	
7													
8		19		20		21		22		23		24	
9													
10		30		29		28		27		26		25	
11										●			
12		31		32		33		34		35		36	
13													

A. Description of original monument and accessories and/or subsequent restoration:

J-11

G.L.O. SET BEECH POST - 16" BEECH N83°E 20.5' AND 18" SUGAR MAPLE S35°W 7.3'. NO EVIDENCE OF THIS POST OR BEARING TREES WAS FOUND.

B. Description of corner evidence found and/or method applied in restoring or reestablishing corner:

J-11

REESTABLISHED THE CORNER BY SINGLE PROPORTIONATE MEASUREMENT, MIDWAY AND ON LINE BETWEEN FOUND CORNERS TO THE EAST AND WEST.

C. Description of monument for corner and accessories established to perpetuate locating the position of the corner:

J-11

SET 4"x 3/8" CONC MON W/BENZIE CO REMON PROGRAM BRASS CAP.

10" MAPLE N05°W 44.06'

10" TW. MAPLE N35°E 25.15'


9" TW. S. MAPLE S40°E 14.73'

14" MAPLE (CLP 4) S40°W 27.13'

SET CARSONITE POST W/LOC TAG NORTH 33'

CTR E-W SAND RD IS 4' NORTH.

FB OLD E-W BARB WIRE FN REMANIS ON THE GROUND 31' +/- 3' SOUTH.

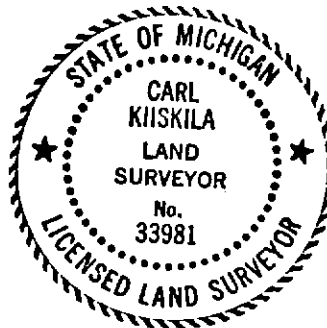

Signed by Carl T. Kiiskila
 Surveyor's Michigan License No. 33981

Date 4-8-97