

**LAND CORNER RECORDATION CERTIFICATE**  
**Filing Requirement of Act 74, Mich. P.A. 1970**

For corners in

<u>BENZIE</u> (County)	Located in:	Corner Code #
1. Public Land Survey	T <u>27N</u> R <u>14W</u>	<u>L-9</u>
	T _____ R _____	_____
	T _____ R _____	_____
	T _____ R _____	_____
2. Property Controlling In Section	S _____ T _____ R _____	_____
	S _____ T _____ R _____	_____
3. Miscellaneous Property in Sec.	S _____ T _____ R _____	_____
	S _____ T _____ R _____	_____

Register of Deeds Stamp & File Number

4. Lot No. \_\_\_\_\_, Recorded Plat \_\_\_\_\_  
 5. Private Claims \_\_\_\_\_

I, CARL KIISKILA, in a field survey on JULY 1, 1996 do hereby state that under requirements of P.A. 74, Michigan P.A. of 1970, the corner points mentioned in lines 1 and 2 above were in conformance with regulations and rules therefore as required in the current manual of survey instructions of the United States Department of the Interior, Bureau of Land Management or by a decree of a Court of Law and /or that the corner points mentioned in lines 3, 4 and 5 above were in conformance with the rules of the Michigan Board of Land Surveyors or by a Decree of a Court of Law; established, re-established, monumented, recovered, found as expressed below:

NOTE: Not more than 2 corners, all in the same town and range, may be recorded on this certificate.

	A	B	C	D	E	F	G	H	I	J	K	L	M
1													
2	6		5		4		3		2		1		
3													
4	7		8		9		10		11		12		
5													
6	10		17		16		15		14		13		
7													
8	19		20		21		22		23		24		
9													
10	30		29		28		27		26		25		
11													
12	31		32		33		34		35		36		
13													

A. Description of original monument and accessories and/or subsequent restoration:

L-9

G.L.O. SET POST - 10° SUGAR MAPLE S56°W 7.3' AND 10° BEECH N51°E 9.2'. NO EVIDENCE OF G.L.O. POST OR BEARING TREES WAS FOUND.

B. Description of corner evidence found and/or method applied in restoring or reestablishing corner:


L-9

REESTABLISHED CORNER BY SINGLE PROPORTIONATE MEASUREMENT BETWEEN REESTABLISHED CORNERS TO THE EAST AND WEST. CTR OF OLD E-W WAGON TRAIL REMAINS IS 14' NORTH. OLD E-W FENCE REMAINS IS 28'+/- NORTH.

C. Description of monument for corner and accessories established to perpetuate locating the position of the corner:

L-9

SET 4" x 36" CONC. BENZIE CO. REMON. MON.  
 W/BRASS CAP AND CARSONITE POST.  
 10° S. MAPLE N38°W 46.38'  
 16° S. MAPLE N08°W 43.90'  
 9° S. MAPLE N26°E 53.02'  
 3° D. CHERRY S45°E 29.42'

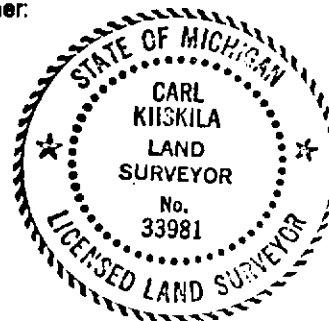

Signed by Carl T. Kiiskila  
 Surveyor's Michigan License No. 33981

Date 4-8-97