

MICHIGAN  
DEPARTMENT OF CONSERVATION  
FORESTRY DIVISION

LAND CORNER RECORD

T. 27 N.R. 15 W


BENZIE COUNTY

DESCRIPTION OF CORNER Sec. corner common to Sec. 20-21-28-29

CORNER MONUMENT Set Std. Dept. Mon.

DATE MONUMENT PLACED AND WITNESSED June 1968

WITNESSES TO CORNER..... 8" Oak S 48 W 42.9'

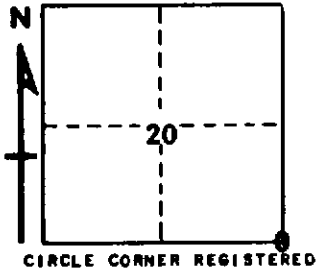

10" R. Pine N 55 W 117.3'

5" R. Pine N 15 E 28.4'

AND E-W Random Due N. 1.0'  
Random S. Due S.E. 2.1'

DESCRIPTION IN DETAIL AS TO HOW CORNER WAS LOCATED AND IDENTIFIED OR RESTORED.

This corner was set on the basis of Greg Shadko's survey of Sec. 21, T27N R15W.

SURVEYOR'S SEAL

SIGNED Carl F. Dorer DATE 7/17/68  
REGISTERED LAND SURVEYOR #12028