

✓
MICHIGAN
DEPARTMENT OF CONSERVATION
FORESTRY DIVISION

LAND CORNER RECORD

T. 27 N.R. 15 W


BENZIE COUNTY

DESCRIPTION OF CORNER 1/4 CORNER COMMON TO SECTIONS 28 - 29

CORNER MONUMENT SET STD. DEPT. MONUMENT

DATE MONUMENT PLACED AND WITNESSED JUNE 1968

WITNESSES TO CORNER..... 5" CEDAR N 35 E 10.9'

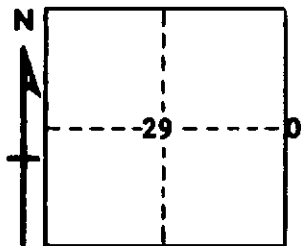

6" Balsam S 75 E 19.0'

8" OAK S 15 W 41.9'

AND N-S Random Due W. 6.4'

DESCRIPTION IN DETAIL AS TO HOW CORNER WAS LOCATED AND IDENTIFIED OR RESTORED.

This corner was set on straight line and halfway between section corners to N & S.

SURVEYOR'S SEAL

SIGNED Carl F. Roer DATE 7/9/68
REGISTERED LAND SURVEYOR
12028