

SURVEY & REMONUMENTATION

APR 14 1998

SECTION

LAND CORNER RECORDATION CERTIFICATE

Filing Requirement of Act 74, Mich. P.A. 1970

LIBER 2 PAGE 62

For corners in

BENZIE

(County)

Located in:

Corner Code #

1. Public Land Survey

T 14W R M-8

T ___ R ___

T ___ R ___

T ___ R ___

2. Property Controlling in Section

S ___ T ___ R ___

S ___ T ___ R ___

3. Miscellaneous Property in Sec.

S ___ T ___ R ___

S ___ T ___ R ___

4. Lot No. _____, Recorded Plat _____

5. Private Claims _____

STATE OF MICHIGAN
BENZIE COUNTY
RECORDED

15 Jan 1998 4:04:49 PM

MICHELLE R. GRAY
REGISTER OF DEEDS
PAGES one

Register of Deeds Stamp & File Number

I, CARL KIISKILA, in a field survey on JULY 1, 19 96 do hereby state that under requirements of P.A. 74, Michigan P.A. of 1970, the corner points mentioned in lines 1 and 2 above were in conformance with regulations and rules therefore as required in the current manual of survey instructions of the United States Department of the Interior, Bureau of Land Management or by a decree of a Court of Law and /or that the corner points mentioned in lines 3, 4 and 5 above were in conformance with the rules of the Michigan Board of Land Surveyors or by a Decree of a Court of Law; established, re-established, monumented, recovered, found as expressed below:

NOTE: Not more than 2 corners, all in the same town and range, may be recorded on this certificate.

A. Description of original monument and accessories and/or subsequent restoration:

A-B

6.L.O. SET POST - 15" BEECH N54°W 4.6' AND 20" BEECH S52°E 23.8'. NO EVIDENCE OF THIS G.L.O. POST OR BEARING TREES WAS FOUND.

B. Description of corner evidence found and/or method applied in restoring or reestablishing corner:

A-B

REESTABLISHED CORNER BY SINGLE PROPORTIONATE MEASUREMENT BETWEEN FOUND SECTION CORNER TO THE NORTH AND REESTABLISHED CORNER TO THE SOUTH.

Ratified by Peer Group
In accordance with P.A. 345

Chairman [Signature]

Date 12/7/95

C. Description of monument for corner and accessories established to perpetuate locating the position of the corner:

A-B


SET 4" x 36" CONC MON W/BENZIE CO REMON PROGRAM BRASS CAP AND CARSONITE POST.

21" S. MAPLE (CLP 4) N60°W 12.43'

4" BEECH N52°E 16.52'

19" S. MAPLE (CLP) S25°W 19.08'

6" BEECH (CLP) N86°E 27.60'

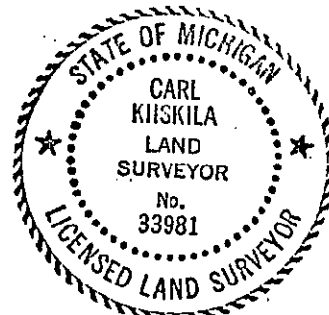

Signed by Carl J. Kiiskila

Date 4-9-97

Surveyor's Michigan License No. 33981