


# LAND CORNER RECORDATION CERTIFICATE

Filing Requirement of Act 74, Mich. PA 1970


For Corners In: <u>Benzie</u> (County)	Located In	Corner Code #	
1. Public Land Survey	T <u>27N</u> R <u>14W</u>	<u>B-9</u>	
	T _____ R _____	_____	
2. Property Controlling in Section	S _____ T _____ R _____	_____	
	S _____ T _____ R _____	_____	
3. Miscellaneous Property in Section	S _____ T _____ R _____	_____	
	S _____ T _____ R _____	_____	
4. Lot No: _____	Recorded Plat: _____		
5. Private Claims: _____			

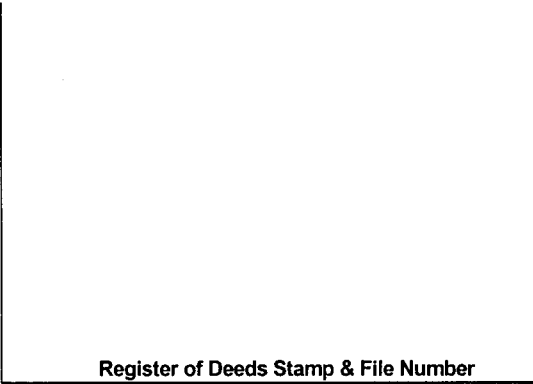

Register of Deeds Stamp & File Number

I, Craig W. McVean, in a field survey on June 15, 1998 do hereby state that under requirements of PA 74, Michigan PA of 1970, the corner points mentioned in lines 1 and 2 above were in conformance with regulations and rules therefore as required in the current manual of survey instructions of the United States Department of the Interior, Bureau of Land Management or by a decree of a Court of Law and/or that the corner points mentioned in lines 3, 4 and 5 above were in conformance with the rules of the Michigan Board of Land Surveyors or by a Decree of a Court of Law; established, re-established, monumented, recovered, found as expressed below:

**NOTE: Not more than 2 corners, all in the same town and range, may be recorded on this certificate.**

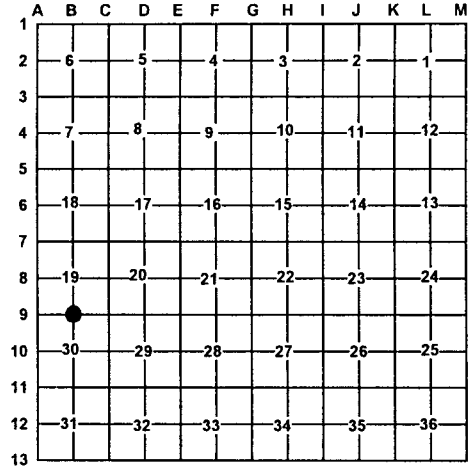

**A. Description of original monument and accessories and/or subsequent restoration:**

- |  |   |
|--|---|
| <p><u>B-9</u> – GLO – Set ¼ post – 1850 – Lucius Lyon<br/>                 Beech 20" N62°E 8L<br/>                 Sugar 7" S51°W 30L<br/>                 - Co. Bk., P. 150-151 – F. Haswell – Sec. 19 Sub. - 1895<br/>                 Planted iron post from original trees.<br/>                 - Co. Bk. II, P. 68-69 – F. Haswell – Sec. 30 Sub. – 1907</p> | <p>- LCRC – L. 1, p. 106 – H. Bruning - 1974<br/>                 FND. 1" x 16" iron pipe<br/>                 N 1 ½°W 34.89' - 6" R. Pine<br/>                 N 67°E 74.46' - 6" R. Pine<br/>                 N80°W 310.33' - 24" Maple<br/>                 S43°W 45.51' - 24" Maple</p> |
|--|---|

**B. Description of corner evidence found and/or method applied in restoring or re-establishing corner:**

B-9 – ¼ Corner common to Sec.'s 19 & 30, T27N, R14W. FND. 2" O.D. iron pipe per H. Bruning – LCRC L. 1. P. 106. Fits 2 Red Pine BT's of record. Fits Haswell's distance E & W fairly well. Monument is in E-W Gravel Rd., 3'± S. of CL. 2" iron pipe accepted as the best available evidence of the position of the original corner.

**C. Description of monument for corner and accessories established to perpetuate locating the position of the corner:**

- B-9 – 2" O.D. iron pipe
- \*North 35.02' to set N & T in W side 12" R. Pine
  - N26°E 44.35' to set N & T in SE side 15" W. Pine
  - \*N63°E 74.52' to set N & T in S side 13" R. Pine
  - S3°E 29.71' to set PK & T in W side U.P.
  - S40°W 45.27' to set N & T in NW side 14" B. Walnut

\*H.B. witnesses



Signed by: Craig W. McVean Date: 8/27/2002  
 Surveyor's Michigan License No.: 39088