

LAND CORNER RECORDATION CERTIFICATE

Filing Requirement of Act 74, Mich. PA 1970

For Corners In: <u>Benzie</u> (County)	Located In	Corner Code #
1. Public Land Survey	T <u>27N</u> R <u>14W</u>	<u>L13</u>
	T _____ R _____	_____
2. Property Controlling in Section	S _____ T _____ R _____	_____
	S _____ T _____ R _____	_____
3. Miscellaneous Property in Section	S _____ T _____ R _____	_____
	S _____ T _____ R _____	_____

Register of Deeds Stamp & File Number

4. Lot No: _____ Recorded Plat: _____

5. Private Claims: _____

I, Craig W. McVean, in a field survey on April 12, 2005 do hereby state that under requirements of PA 74, Michigan PA of 1970, the corner points mentioned in lines 1 and 2 above were in conformance with regulations and rules therefore as required in the current manual of survey instructions of the United States Department of the Interior, Bureau of Land Management or by a decree of a Court of Law and/or that the corner points mentioned in lines 3, 4 and 5 above were in conformance with the rules of the Michigan Board of Land Surveyors or by a Decree of a Court of Law; established, re-established, monumented, recovered, found as expressed below:

NOTE: Not more than 2 corners, all in the same town and range, may be recorded on this certificate.

	A	B	C	D	E	F	G	H	I	J	K	L	M
1													
2	6		5		4		3		2		1		
3													
4	7		8		9		10		11		12		
5													
6	18		17		16		15		14		13		
7													
8	19		20		21		22		23		24		
9													
10	30		29		28		27		26		25		
11													
12	31		32		33		34		35		36		
13													

A. Description of original monument and accessories and/or subsequent restoration:


L13 – GLO – Set ¼ Post – Alvin Burt – 1839
 Sugar 8" N70°E 20 L.
 Sugar 14" N71°W 33 L.
 - LCRC – L. 1, p. 346 – C. Kiiskila - 1997
 Reest. S 1/4 Cor. Midway and on-line between
 Reest. 'M13' and reest. 'K13'. Set DNR Mon. and
 Carsonite post. 3" S. Maple N20°W 7.74';
 4" S. Maple N25°E 13.09'; 8" S. Maple N55°E 25.05'
 7" Tw. S. Maple S10°E 8.59'; N1/4 Sec. 1
 T26N, R14W - Set DNR Mon. S89° 00' E 10.55'

B. Description of corner evidence found and/or method applied in restoring or re-establishing corner:

L13 – Standard ¼ corner common to Sec. 36 – Fd. 4" DNR Alum. Cap on 1" Galv. iron pipe per Kiiskila. No GLO evidence. DNR Mon. accepted as a careful and faithful reestablishment of the position of the original corner.

C. Description of monument for corner and accessories established to perpetuate locating the position of the corner:

L13 – 4" DNR Alum. Cap on 1" galv. iron pipe
 N22°W 7.76' to Fd. Nail in E. side 4" S. Maple (CK)
 N26°E 13.08' to Fd. nail in NW side 5" S. Maple (CK)
 N58°E 25.04' to Fd. nail in NW side 10" S. Maple (CK)
 S10°E 8.60' to Fd. nail in E. side 8" Tw. S. Maple (CK)
 Fd. Blue Carsonite Post NE 0.6'
 East 10.55' to 'L1' T26N, R14W – DNR Mon.

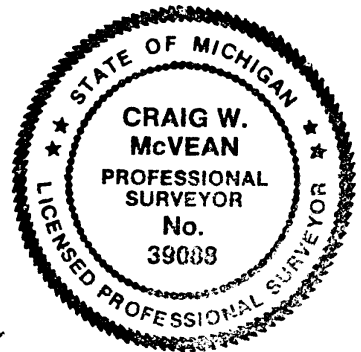

Signed by: *Craig W. McVean*
 Surveyor's Michigan License No.: 39088

Date: 5/9/2005