

RATIFIED BY THE BERRIEN COUNTY SURVEY PEER GROUP AS THE OFFICIAL CORNER UNDER MICHIGAN PUBLIC ACT 345 OF 1990

08/24/94

111#1725

A33

CORNER

\$7.00

08/24/94

111#1725

A33

STATE REMON FEE \$2.00

BERRIEN COUNTY REMONUMENTATION
LAND CORNER RECORDATION CERTIFICATE
 Filing Requirement of Act 74, Mich. P.A. 1970

[Signature]
 5-26-94
 For corners in
Berrien
 (County)

Located In:	Corner Code #
T 3S R 17W	A-2
T R	
T R	
T R	
T R	
S T R	
S T R	
S T R	
S T R	

REGISTER OF DEEDS
 BERRIEN COUNTY MICHIGAN
[Signature]

AUG 24 10 54 AM '94

RECORDED

Register of Deeds Stamp & File Number

- Public Land Survey
- Property Controlling in Section
- Miscellaneous Property in Sec.
- Lot No. _____, Recorded Plat _____
- Private Claims _____

	A	B	C	D	E	F	G	H	I	J	K	L	M
2	6	5	4	3	2	1							
3													
4	7	8	9	10	11	12							
5													
6	18	17	16	15	14	13							
7													
8	19	20	21	22	23	24							
9													
10	30	29	28	27	26	25							
11													
12	31	32	33	34	35	36							
13													

I, V.J. Strebs, in a field survey on 28 July, 19 94, do hereby certify that under requirements of P.A. 74, Michigan P.A. of 1970, the corner points mentioned in lines 1 and 2 above were in conformance with regulations and rules therefore as required in the current manual of survey instructions of the United States Department of the Interior, Bureau of Land Management or by a decree of a Court of Law and/or that the corner points mentioned in lines 3, 4 and 5 above were in conformance with the rules of the Michigan Board of Land Surveyors or by a Decree of a Court of Law; established, re-established, monumented, re-monumented, recovered, found as expressed below:

NOTE: Not more than 4 corners, all in the same town and range, may be recorded on this certificate.

A. Description of original monument and accessories and/or subsequent restoration:

Corner was not set by G.L.O. in original surveys
 1968 to present Stone & Iron in Monument Box
 1990 - N45°E - 41.54' - P.K. Nail in N.W. Cor. of R.R. tie Post
 N35°W - 83.60 - Center of Telephone Cable Box
 S20°W - 119.75' - P.K. Nail in East Face of Pole
 S60°E - 155.0' - P.K. Nail in S.W. Face of Pole

B. Description of corner evidence found and/or method applied in restoring or reestablishing corner:

Found Iron Rod and Stone in Monument Box


SURVEY & REMONUMENTATION

SEP 15 1994

COMMISSION

C. Description of monument for corner and accessories established to perpetuate locating the position of the corner:

Pulled Iron and Stone
 Set 1" x 3ft Iron Pipe with B.C.R.P. Brass Cap in Monument Box
 Nail & Witness Tag in Power Pole (B-102-36) - S24°W - 78.90'
 Nail & Witness Tag in Power Pole (B-102-36) - S75°E - 155.20'
 1" Iron Pipe - North - 59.75'
 B.C.R.P. Brass Cap in Monument Box - North - 45.8-'
 Nail & Witness Tag in Corner Fence Post - N45°E - 45.55'

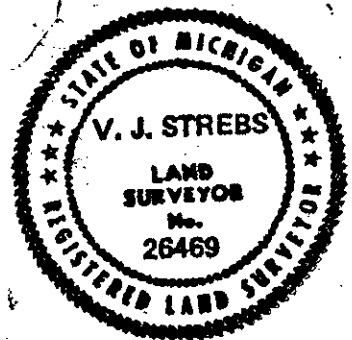

Signed by *[Signature]*
 Surveyor's Michigan License No. 26469

Date 5 AUGUST 1994