

APPROVED BY THE BERRIEN COUNTY SURVEY PEER GROUP AS THE ORIGINAL CORNER UNDER MICHIGAN PUBLIC ACT 345 OF 1990

**BERRIEN COUNTY REMONUMENTATION
LAND CORNER RECORDATION CERTIFICATE**

RECORDED

98 OCT 28 AM 11:02

Filing Requirement of Act 74, Mich. P.A. 1970

BERNICE TRETHERWAY
REGISTER OF DEEDS
BERRIEN COUNTY, MICHIGAN

For corners in

WATERVLIET Township

BERRIEN Located in: Corner Code #

1. Public Land Survey T.3..S R.17 W.....M-8.....
T..... R..... E1/4 POST, SEC 24.
2. Property Controlling S..... T..... R.....
in Section S..... T..... R.....
3. Miscellaneous S..... T..... R.....
Property in Sec. S..... T..... R.....
4. Lot No. Recorded Plat
5. Private Claims.....

10/28/98 111#4148 A66
CORNER \$9.00
10/28/98 111#4148 A66
STATE REMON FEE \$2.00

Register of Deeds Stamp & File Number

I, **George J. Mitchell**....., in a filed survey on ...**September 2, 1998**..... do hereby certify that under requirements of P.A. 74, Michigan P.A. of 1970, the corner points mentioned in lines 1 and 2 above were in conformance with regulations and rules therefore as required in the current manual of survey instructions of the United States Department of the Interior, Bureau of Land Management or by decree of a Court of Law and/or that the corner points mentioned in lines 3, 4, and 5 above were in conformance with the rules of the Michigan Board of Land Surveyors or by decree of a Court of Law; established, re-established, monumented, re-monumented, recovered, found as expressed below:

NOTE: Not more than 4 corners, all in the same town & range, may be recorded on this certificate.

A. Description of original monument and accessories and/or subsequent restoration:

M-8

SEE SHEET 2 OF 2

A	B	C	D	E	F	G	H	I	J	K	L	M
2	6	5	4	3	2	1						
3												
4	7	8	9	10	11	12						
5												
6	18	17	16	15	14	13						
7												
8	19	20	21	22	23	24						
9												
10	30	29	28	27	26	25						
11												
12	31	32	33	34	35	36						
13												

B. Description of corner evidence found and/or method applied in restoring or reestablishing corner:

M-8) FOUND BRONZE PLATE IN MON BOX FROM CORNER HISTORY AND ACCEPTED ITS LOCATION AS A CAREFUL AND FAITHFUL PERPETUATION OF THE POSITION OF THE ORIGINAL CORNER.

THIS CORNER WAS APPROVED BY THE BERRIEN COUNTY SURVEYORS PEER GROUP ON SEPTEMBER 10, 1998


C. Description of monument for corner and accessories established to perpetuate locating the position of the corner:

M-8) EAST QUARTER POST, SECTION 24, TOWN 3 SOUTH, RANGE 17 WEST.

REPLACED BRONZE PLATE WITH BERRIEN COUNTY STANDARD 1 INCH PIPE. SET BRASS CAP WITH DRILL HOLE AND NUMBER 19618 STAMPED ON TOP. PIPE WAS SET IN A MONUMENT BOX.

WITNESS TAG & NAIL SET IN SE SIDE OF POWER POLE	AZ.	195°	101.00 FEET
WITNESS TAG & NAIL SET IN NE SIDE OF 28" MULLBERRY	AZ.	270°	46.91 FEET
WITNESS TAG & NAIL SET IN NE SIDE OF POWER POLE	AZ.	330°	72.89 FEET
VAN BUREN COUNTY CORNER	AZ.	000°	28.03 FEET
CORNER M-8 TO M-7 MEASURED			2631.02 FEET
CORNER M-8 TO M-9 MEASURED			2625.37 FEET

Signed by George J. Mitchell Date October 26, 1998
Surveyor's Michigan License No. 19618.....

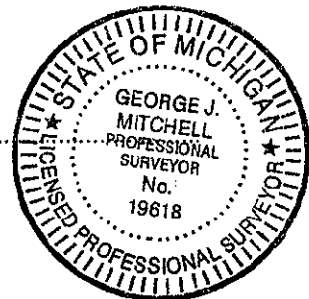

SURVEY & REMONUMENTATION

SHEET 1 OF 2

NOV 20 1998

SECTION

LIBER

4 PAGE

95

GOVERNMENT CORNER HISTORY

EAST QUARTER POST, SECTION 24
TOWN 3 SOUTH, RANGE 17 WEST

M-8

- 1827 WILLIAM BROOKFIELD
SET POST
9" BEECH S40W 22 LKS
9" BEECH N42W 45 LKS
- 1971 A. HOWARD FD BRONZE CAP IN MON BOX
WILLOW N45W 39.10'
CENTER C. & O. RAILROAD SOUTH 299.63'
CENETR OF ROAD WEST 1.0'
- 1971 D. MIDDLETON L.C.R.C. BRONZE CAP IN MON BOX
SAME WITNESSES AS ABOVE
- 1972 A. HOWARD FD BRONZE CAP IN MON BOX
SAME WITNESSES AS ABOVE
- 1975 WIGHTMAN FD PLATE IN MON BOX
16" WILLOW N30W 39.00'
12" BEECH N50W 57.10'
10" BEECH S85W 48.13'
- 1977 WIGHTMAN FD PLATE IN MON BOX
20" WILLOW N45W 39.07'
14" SASSAFRAS WEST 48.52'
GUARD POST S80E 18.12'
GUARD POST N55W 24.12'
- 1998 G. MITCHELL FD BRONZE PLATE IN MON BOX

SURVEY &
REMONUMENTATION

NOV 20 1998

SECTION