

RATIFIED BY THE BERRIEN COUNTY SURVEY PEER GROUP AS THE OFFICIAL CORNER UNDER MICHIGAN PUBLIC ACT 345 OF 1990

08/24/94

111#1725 A33
CORNER \$7.00
08/24/94 111#1725 A33
STATE REMON FEE \$2.00

BERRIEN COUNTY REMONUMENTATION
LAND CORNER RECORDATION CERTIFICATE
Filing Requirement of Act 74, Mich. P.A. 1970

For corners in
Berrien
(County)

Located In: Corner Code #/

1. Public Land Survey	T <u>3S</u> R <u>18W</u>	<u>K-2</u>
	T _____ R _____	_____
	T _____ R _____	_____
	T _____ R _____	_____
2. Property Controlling in Section	S _____ T _____ R _____	_____
	S _____ T _____ R _____	_____
3. Miscellaneous Property in Sec.	S _____ T _____ R _____	_____
	S _____ T _____ R _____	_____

4. Lot No. _____, Recorded Plat _____
5. Private Claims _____

REGISTER OF DEEDS
BERRIEN COUNTY MICHIGAN

AUG 24 10 55 AM '94

RECORDED

Register of Deeds Stamp & File Number

I, V.J. Strebs, in a field survey on 16 August, 19 94, do hereby certify that under requirements of P.A. 74, Michigan P.A. of 1970, the corner points mentioned in lines 1 and 2 above were in conformance with regulations and rules therefore as required in the current manual of survey instructions of the United States Department of the Interior, Bureau of Land Management or by a decree of a Court of Law and/or that the corner points mentioned in lines 3, 4 and 5 above were in conformance with the rules of the Michigan Board of Land Surveyors or by a Decree of a Court of Law; established, re-established, monumented, re-monumented, recovered, found as expressed below:

NOTE: Not more than 4 corners, all in the same town and range, may be recorded on this certificate.

	A	B	C	D	E	F	G	H	I	J	K	L	M
2	6		5		4		3		2		1		
3													
4	7		8		9		10		11		12		
5													
6	18		17		16		15		14		13		
7													
8	19		20		21		22		23		24		
9													
10	30		29		28		27		26		25		
11													
12	31		32		33		34		35		36		
13													

A. Description of original monument and accessories and/or subsequent restoration:

1830 - William Brookfield, G.L.O.
Pine 7 - N17½°E - 1.32 chains

1983 - John Kamer
(set ½" Rebar w/cap)
R/W Fence - West - 148.00'
Stone - East - 1311.59'
½" Rebar w/cap-South - 1267.72'

B. Description of corner evidence found and/or method applied in restoring or reestablishing corner:

Found ½" Rebar


SURVEY &
REMONUMENTATION
SEP 15 1994
COMMISSION

C. Description of monument for corner and accessories established to perpetuate locating the position of the corner:

Pulled out Rebar
Set 36"x4" Diameter concrete monument w/ B.C.R.P BRASS CAP
(witnesses below have nail & witness tag through ID Cap)
1"x3 ft Iron Pipe on ¼ line extended West on r/w Fence - 217.44'
1"x3 ft Iron Pipe at right angles to ¼ line on r/w - fence - North - 200.35'
1"x3 ft Iron Pipe on ¼ line - East - 67.52'
1"x3 ft Iron Pipe at Right angles to ¼ lines - South - 172.85'

Signed by [Signature]
Surveyor's Michigan License No. 26469

Date 18 August 1994

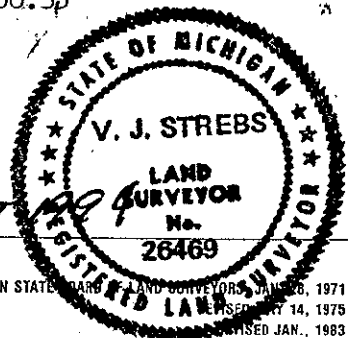

FORM APPROVED BY MICHIGAN STATE BOARD OF LAND SURVEYORS, JAN 26, 1971
REVISED JAN., 1983