

MAINTAINED BY THE BERRIEN COUNTY
SURVEY PEER GROUP AS THE
OFFICIAL CORNER UNDER MICHIGAN
PUBLIC ACT 345 OF 1990

08/24/94

111#1725 A33
CORNER \$7.00
111#1725 A33
STATE REMON FEE \$2.00

BERRIEN COUNTY REMONUMENTATION
LAND CORNER RECORDATION CERTIFICATE
Filing Requirement of Act 74, Mich. P.A. 1970

REGISTER OF DEEDS
BERRIEN COUNTY MICHIGAN

Aug 24 10 54 AM '94

RECORDED

[Signature]
5-26-94

For corners in

Berrien (County) Located in: _____ Corner Code #/

1. Public Land Survey	T <u>3S</u> R <u>18W</u>	<u>K-3</u>
	T _____ R _____	_____
	T _____ R _____	_____
	T _____ R _____	_____
2. Property Controlling in Section	S _____ T _____ R _____	_____
	S _____ T _____ R _____	_____
3. Miscellaneous Property in Sec.	S _____ T _____ R _____	_____
	S _____ T _____ R _____	_____

Register of Deeds Stamp & File Number

4. Lot No. _____, Recorded Plat _____
5. Private Claims _____

A	B	C	D	E	F	G	H	I	J	K	L	M
2	6	5	4	3	2	1						
3												
4	7	8	9	10	11	12						
5												
6	18	17	16	15	14	13						
7												
8	19	20	21	22	23	24						
9												
10	30	29	28	27	26	25						
11												
12	31	32	33	34	35	36						
13												

I, V.J. Strebs, in a field survey on 28 July, 19 94, do hereby certify that under requirements of P.A. 74, Michigan P.A. of 1970, the corner points mentioned in lines 1 and 2 above were in conformance with regulations and rules therefore as required in the current manual of survey instructions of the United States Department of the Interior, Bureau of Land Management or by a decree of a Court of Law and/or that the corner points mentioned in lines 3, 4 and 5 above were in conformance with the rules of the Michigan Board of Land Surveyors or by a Decree of a Court of Law; established, re-established, monumented, re-monumented, recovered, found as expressed below:

NOTE: Not more than 4 corners, all in the same town and range, may be recorded on this certificate.

- A. Description of original monument and accessories and/or subsequent restoration:
- | | |
|-----------------------------------|-------------------------------------|
| 1830 - William Brookfield, G.L.O. | 1979, 1983, 1992 |
| Poplar 16 - S26°E - 8 Links | (Iron Rod in Monument Box) |
| Poplar 20 - N63°E - 9 Links | P.K. in Power Pole - South - 30.64' |
| 1883 - Luther Hemingway | P.K. in 20" Apple - S50°W - 57.00' |
| (Found Stake) | P.K. in 16" Apple - S70°W - 92.08' |
| Sugar 18 - N36°E - 46 Links | |

B. Description of corner evidence found and/or method applied in restoring or reestablishing corner:

Found Iron Rod in Monument Box


**SURVEY &
REMONUMENTATION**

SEP 15 1994

COMMISSIONER

C. Description of monument for corner and accessories established to perpetuate locating the position of the corner:

- Pulled out Iron Rod
- Set 1" x 3 FT Iron Pipe with B.C.R.P. Brass Cap in Monument Box
- Nail & Witness Tag in Power Pole (B-110-587) - South - 30.81'
- Nail & Witness Tag in Power Pole (-B-102-157) - North - 34.69'
- Nail & Witness Tag in 24" Apple - S75°W - 58.23'
- Nail & Witness Tag in 18" Ash - N75°E - 144.55'

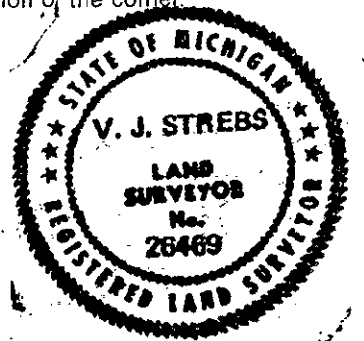

Signed by *[Signature]*
Surveyor's Michigan License No. 26469

Date 5 August 1994