

RATIFIED BY THE BERRIEN COUNTY SURVEY PEER GROUP AS THE OFFICIAL CORNER UNDER MICHIGAN PUBLIC ACT 345 OF 1990

08/24/94

111#1725

A33

CORNER

\$7.00

08/24/94

111#1725

A33

STATE REMOIN FEE \$2.00

BERRIEN COUNTY REMONUMENTATION
LAND CORNER RECORDATION CERTIFICATE
 Filing Requirement of Act 74, Mich. P.A. 1970

[Signature]
 7-06-94
 For corners in
Berrien
 (County)

REGISTER OF DEEDS
 REGISTERED
 REGISTER OF DEEDS
 REGISTERED
 REGISTER OF DEEDS
 REGISTERED

Aug 24 10 55 AM '94

RECORDED

	Located In:	Corner Code #/
1. Public Land Survey	T <u>3S</u> R <u>18W</u>	<u>L-1</u>
	T _____ R _____	_____
	T _____ R _____	_____
	T _____ R _____	_____
2. Property Controlling in Section	S _____ T _____ R _____	_____
	S _____ T _____ R _____	_____
3. Miscellaneous Property in Sec.	S _____ T _____ R _____	_____
	S _____ T _____ R _____	_____
4. Lot No. _____, Recorded Plat _____		
5. Private Claims _____		

Register of Deeds Stamp & File Number

I, V.J. Strebs, in a field survey on 16 August, 19 94, do hereby certify that under requirements of P.A. 74, Michigan P.A. of 1970, the corner points mentioned in lines 1 and 2 above were in conformance with regulations and rules therefore as required in the current manual of survey instructions of the United States Department of the Interior, Bureau of Land Management or by a decree of a Court of Law and/or that the corner points mentioned in lines 3, 4 and 5 above were in conformance with the rules of the Michigan Board of Land Surveyors or by a Decree of a Court of Law; established, re-established, monumented, re-monumented, recovered, found as expressed below:

	A	B	C	D	E	F	G	H	I	J	K	L	M
2	6	5	4	3	2								
3													
4	7	8	9	10	11	12							
5													
6	18	17	16	15	14	13							
7													
8	19	20	21	22	23	24							
9													
10	30	29	28	27	26	25							
11													
12	31	32	33	34	35	36							
13													

NOTE: Not more than 4 corners, all in the same town and range, may be recorded on this certificate.

A. Description of original monument and accessories and/or subsequent restoration:

- 1830 - William Brookfield, G.L.O.
 Beech 9 - N34 $\frac{1}{2}$ °E - 34 links
 Hemlock 12 - N01 $\frac{1}{2}$ °W - 40 links
- 1883 - Luther Hemingway found post
 (No Witnesses)


B. Description of corner evidence found and/or method applied in restoring or reestablishing corner:

Found 1" Iron Pipe in Swamp

**SURVEY &
 REMONUMENTATION**
 SEP 15 1994
COMMISSION

C. Description of monument for corner and accessories established to perpetuate locating the position of the corner:

- * Monument inside of 4"x4 ft P.V.C. Pipe w/BCRP. Brass Cap. in Swamp
- Iron Pipe - N30°E - 9.26'
- Nail & Witness Tag in 36" Oak - N25°E - 58.91'
- Nail & Witness Tag in 18" Maple - N30°E - 57.17'
- Nail & Witness Tag in 6" Gum - N40°E - 32.41'

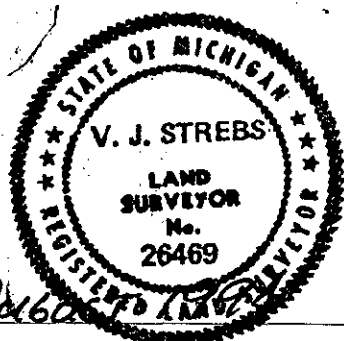

Signed by *[Signature]* Date 18 Aug 94
 Surveyor's Michigan License No. 26469