

BERRIEN COUNTY REMONUMENTATION
LAND CORNER RECORDATION CERTIFICATE
Filing Requirement of Act 74, Mich. P.A. 1970

REGISTER OF DEEDS
BERRIEN COUNTY MICHIGAN
Barbara J. [unclear]

AUG 24 10 54 AM '94

RECORDED

Register of Deeds Stamp & File Number

For corners in Berrien (County) Located In: _____ Corner Code # _____

1. Public Land Survey	T <u>3S</u> R <u>18W</u>	<u>L-3</u>
	T _____ R _____	_____
	T _____ R _____	_____
	T _____ R _____	_____
2. Property Controlling in Section	S _____ T _____ R _____	_____
	S _____ T _____ R _____	_____
3. Miscellaneous Property in Sec.	S _____ T _____ R _____	_____
	S _____ T _____ R _____	_____

4. Lot No. _____, Recorded Plat _____

5. Private Claims _____

	A	B	C	D	E	F	G	H	I	J	K	L	M
2	6	5	4	3	2	1							
3													
4	7	8	9	10	11	12							
5													
6	18	17	16	15	14	13							
7													
8	19	20	21	22	23	24							
9													
10	30	29	28	27	26	25							
11													
12	31	32	33	34	35	36							
13													

I, V.J. Strebs, in a field survey on 28 July, 19 94, do hereby certify that under requirements of P.A. 74, Michigan P.A. of 1970, the corner points mentioned in lines 1 and 2 above were in conformance with regulations and rules therefore as required in the current manual of survey instructions of the United States Department of the Interior, Bureau of Land Management or by a decree of a Court of Law and/or that the corner points mentioned in lines 3, 4 and 5 above were in conformance with the rules of the Michigan Board of Land Surveyors or by a Decree of a Court of Law; established, re-established, monumented, re-monumented, recovered, found as expressed below:

NOTE: Not more than 4 corners, all in the same town and range, may be recorded on this certificate.

- A. Description of original monument and accessories and/or subsequent restoration:
- 1830 - William Brookfield, G.L.O.
Poplar 40 - N42 $\frac{1}{2}$ °W - 23 links
Poplar 10 - N64 $\frac{1}{2}$ °E - 2 links
 - 1883 Luther Hemingway
Found Stones
 - 1979, 1983 & 1992 (Iron Rod in Monument Box)
P.K. Nail in Power Pole - N40°E - 55.18'
P.K. Nail in Guard Post - N50°W - 35.28'
P.K. Nail 30" Maple - N75°W - 74.25'

B. Description of corner evidence found and/or method applied in restoring or reestablishing corner:


Found 5/8" iron rod in Monument Box

SURVEY & REMONUMENTATION

SEP 15 1994

COMMISSION

- C. Description of monument for corner and accessories established to perpetuate locating the position of the corner:
- Pulled Iron Rod
Set 1" x 3 ft iron pipe iwth B.C.R.P. Bass cap in Monument Box
Nail & Witness Tag in Power Pole (B102-154) - N40°E - 43.28'
Nail & Witness Tag in 16" Maple - N15°W - 69.55'
Nail & Witness Tag in 10" Maple - S40°E - 53.83'
Nail & Witness in Triple Mulberry - S60°W - 67.17'

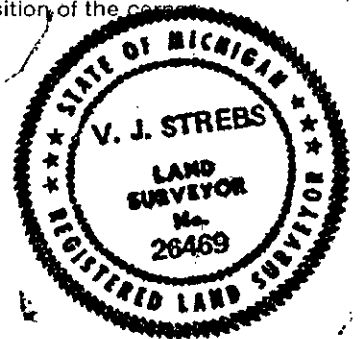

Signed by *V. J. Strebs*
Surveyor's Michigan License No. _____

Date 5 August 1994