

SURVEY &
REMONUMENTATION


Book #1

NOV 21 1996
COMMISSION

Property Controlling Corner

1995

Town 4 South Range 18 West

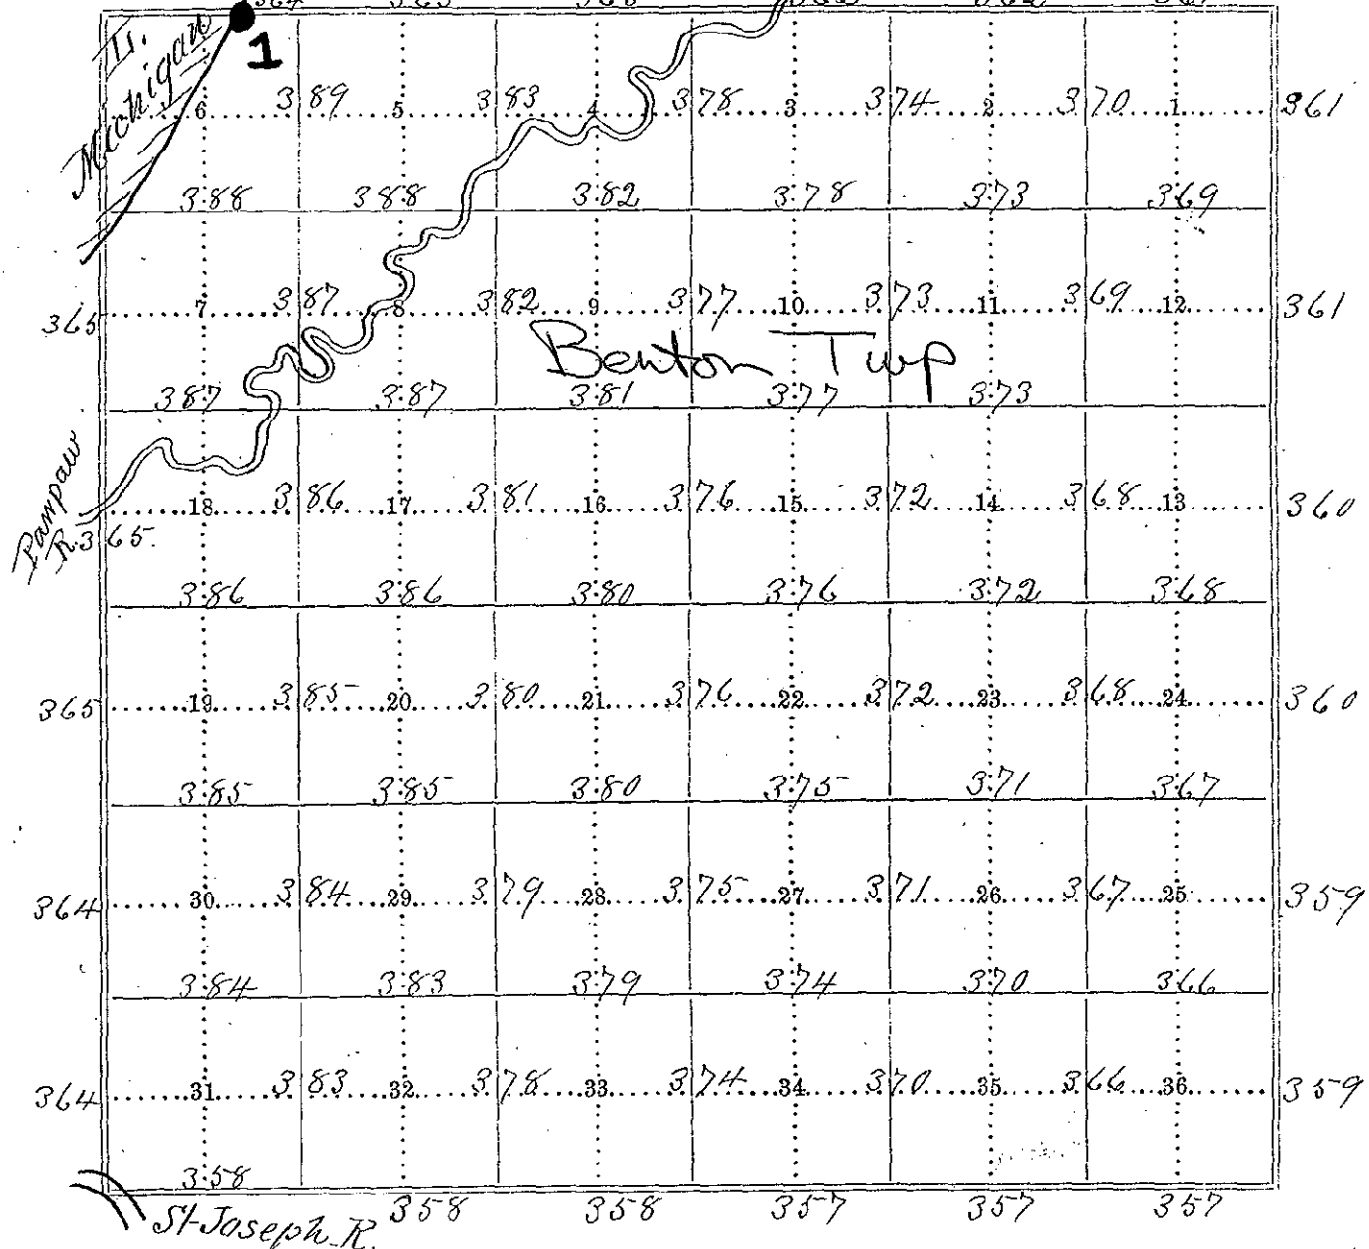

Meanders on Pages 389 to 395

Barrier Co.