

RAISED BY THE BERRIEN COUNTY SURVEY PEER GROUP AS THE OFFICIAL CORNER UNDER MICHIGAN PUBLIC ACT 345 OF 1990

Charles W. Barger
10-23-97
For corners in
BERRIEN (County)

BERRIEN COUNTY REMONUMENTATION
LAND CORNER RECORDATION CERTIFICATE
Filing Requirement of Act 74, Mich. P.A. 1970

RECORDED
97 OCT 31 PM 2:03
BERNICE TRETHERWAY
REGISTER OF DEEDS
BERRIEN COUNTY, MICHIGAN

1. Public Land Survey	T <u>4</u> R <u>18</u>	A-9
	T _____ R _____	_____
	T _____ R _____	_____
	T _____ R _____	_____
2. Property Controlling in Section	S _____ T _____ R _____	_____
	S _____ T _____ R _____	_____
3. Miscellaneous Property in Sec.	S _____ T _____ R _____	_____
	S _____ T _____ R _____	_____
4. Lot No. _____, Recorded Plat _____		
5. Private Claims _____		

10/31/97 111W2484 A99
Register of Deeds Stamp & File Number \$9.00
10/31/97 111W2484 A99
STATE REMON FEE \$2.00

A	B	C	D	E	F	G	H	I	J	K	L	M
2	6	5	4	3	2	1						
3												
4	7	8	9	10	11	12						
5												
6	18	17	16	15	14	13						
7												
8	19	20	21	22	23	24						
9												
10	30	29	28	27	26	25						
11												
12	31	32	33	34	35	36						
13												

I, CHARLES W. BARGER, in a field survey on OCTOBER, 19 97, do hereby certify that under requirements of P.A. 74, Michigan P.A. of 1970, the corner points mentioned in lines 1 and 2 above were in conformance with regulations and rules therefore as required in the current manual of survey instructions of the United States Department of the Interior, Bureau of Land Management or by a decree of a Court of Law and/or that the corner points mentioned in lines 3, 4 and 5 above were in conformance with the rules of the Michigan Board of Land Surveyors or by a Decree of a Court of Law; established, re-established, monumented, re-monumented, recovered, found as expressed below:

NOTE: Not more than 4 corners, all in the same town and range, may be recorded on this certificate.

A. Description of original monument and accessories and/or subsequent restoration:

J. MULLETT SET POST CORNER TO SEC 19 & 30
1830 .20 S OF PST
W. OAK 20 N20E 1.04
HICKORY 9 S14E 58

SURVEY &
REMONUMENTATION
NOV 21 1997
COMMISSION

B. Description of corner evidence found and/or method applied in restoring or reestablishing corner:


ORIGINAL CORNER DESTROYED DURING CONSTRUCTION 1986-1987.

C. BARGER SET P.K.
NOV 1996 SET P.K. SE COR SEC 24-4-19 N 13.2'
HYDT N53DEG05'E 46.61'
LIGHT POLE S31DEG13'W 46.54'
PP N60DEGW 48.41'

C. Description of monument for corner and accessories established to perpetuate locating the position of the corner:

A-9 1" PIPE 36" LONG WITH 2½" REMONUMENTATION BRASS CAP IN MONUMENT BOX
2½" REMONUMENT MARKER OVER 1" PIPE N 13.2'
HYDRANT N53DEG05'E 46.61'
LIGHT POLE S31DEG13'W 46.54'
WITNESS TAG PP N60DEGW 48.41'

THIS MONUMENT IS ACCEPTED AS THE BEST AVAILABLE EVIDENCE OF THIS CORNER.

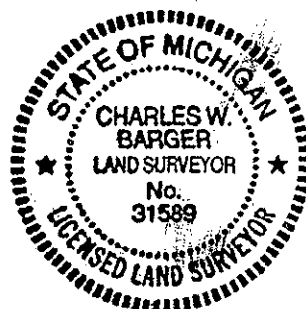

Signed by *Charles W. Barger*
Surveyor's Michigan License No. 31589

Date OCTOBER 31, 1997

BARGER ENGINEERING, INC.
BERRIEN COUNTY REMONUMENTATION

SOUTHWEST CORNER SECTION 19, TOWNSHIP 4 SOUTH, RANGE 18 WEST
(A9)

COLFAX AVENUE TO EAST

J. Mullett
Feb 1830

Set Post Corner to Sec 19 & 30
.20 S of Pst
W. Oak 20 N20E 1.04
Hickory 9 S14E 58

Wightman & Assoc
1979

Manhole Over Corner
Iron Pipe 33' W & 462' S

C. Barger
1986

Manhole Over Corner
Iron Pipe W. 33.0'
Iron Pipe S35degW 56.77'

1986-1987

Corner Destroyed by Construction

C. Barger
Nov 1996

Set P.K.
Set P.K. SE Cor Sec 24-4-19 (13.2'N)
Hydt N53deg05'E 46.61'
Light Pole S31deg13'W 46.54'
Power Pole N60degW 48.41'

BERRIEN COUNTY
REMONUMENTATION

NOV 21 1997

COMMISSION

JOB ASSIGNMENT 1996-02-0256

LIBER

4 PAGE

2