

RATIFIED BY THE BERRIEN COUNTY  
SURVEY PEER GROUP AS THE  
OFFICIAL CORNER UNDER MICHIGAN  
PUBLIC ACT 345 OF 1990

**Berrien County Remonumentation Program  
LAND CORNER RECORDATION CERTIFICATE**

00 NOV - 8 PM 12: 51

RECORDED

Filing Requirement of Act 74, Mich. P.A. 1970

DEVIDE TRETHERWAY  
REGISTER OF DEEDS  
BERRIEN COUNTY, MICHIGAN

11/08/00 111#6048 A66  
CORNER \$7.00  
11/08/00 111#6048 A66  
STATE REMON FEE \$2.00

Register of Deeds Stamp & File  
Number

Berrien (County)	Located In:	Corner Code #
1. Public Land Survey	T <u>4S</u> R <u>18W</u>	<u>K-13</u>
	T <u>    </u> R <u>    </u>	<u>    </u>
	T <u>    </u> R <u>    </u>	<u>    </u>
	T <u>    </u> R <u>    </u>	<u>    </u>
2. Property Controlling in Section	S <u>    </u> T <u>    </u> R <u>    </u>	<u>    </u>
	S <u>    </u> T <u>    </u> R <u>    </u>	<u>    </u>
3. Miscellaneous Property in Sec.	S <u>    </u> T <u>    </u> R <u>    </u>	<u>    </u>
	S <u>    </u> T <u>    </u> R <u>    </u>	<u>    </u>

4. Lot No. \_\_\_\_\_, Recorded Plat \_\_\_\_\_  
5. Private Claims \_\_\_\_\_

I, Alan K. Bartlett, in a field survey on March, 29 2000  
do hereby state that under requirements of P.A. 74, Michigan P.A. of 1970, the  
corner points mentioned in lines 1 and 2 above were in conformance with  
regulations and rules therefore as required in the current manual of survey  
instructions of the United States Department of the Interior, Bureau of Land  
Management or by a decree of a Court of Law and /or that the corner points  
mentioned in lines 3, 4 and 5 above were in conformance with the rules of the  
Michigan Board of Land Surveyors or by a Decree of a Court of Law;  
established, re-established, monumented, recovered, found as expressed  
below:

	A	B	C	D	E	F	G	H	I	J	K	L	M
1													
2	6		5		4		3		2		1		
3													
4	7		8		9		10		11		12		
5													
6	18		17		16		15		14		13		
7													
8	19		20		21		22		23		24		
9													
10	30		29		28		27		26		25		
11													
12	31		32		33		34		35		36		
13													

**NOTE: Not more than 2 corners, all in the same town and range, may be recorded on this certificate.**

A. Description of original monument and accessories and/or subsequent restoration:

- GLO- WEST ON SOUTH SIDE OF SECTION 36 AT 80.00 CHAINS SET  
POST 1/4 SECTION CORNER. WITNESSES: 7' SUGAR N40°E 32 LINKS;  
18" BEECH N40W 35 LINKS
- 1999- DANCH, HARNER; FOUND 5/8" BAR IN MON BOX; EAST 25.90' IRON ROD; N45°W 39.17' MDOT  
NAIL; N80°W 92/03' S FACE APPLE TREE

Unknown ALTON HOWARD; SET IRON ROD OVER STONE

- 1967 ALTON HOWARD; HALF MILE DISTANCE MEASURED JUNE 10, 1967 2630.45' K-13 TO K-12
- 1966 ALTON HOWARD; STONE & IRON, MEASURED 89°45' NORTHWEST QUADRANT EAST 25.74' RECORDED JOG.
- 1983 BERRIEN COUNTY ROAD COMMISSION; HALF MILE DISTANCE MEASURED 2632.80' K-13 TO K-12; JUNE 1983 SET MON BOX (NO  
DESCRIPTION OF MONUMENT). WITNESSES: 12" ELM NW 50', TELEPHONE POLE NE 38.5', MAIL BOX SW 30.5', COR. FOR  
TOWNSHIP JOG IS 25.74' EAST.

B. Description of corner evidence found and/or method applied in restoring or reestablishing corner:

FOUND IRON PIPE IN MON BOX AT CENTERLINE OF TOWNLINE ROAD AND 1.8' WEST OF THE CENTERLINE OF HILLANDALE ROAD. SET  
OVER STONE (DID NOT REMOVE). THIS CORNER APPROVED BY BERRIEN COUNTY REMON PER GROUP OF SURVEYORS.


C. Description of monument for corner and accessories established to perpetuate locating the position of the corner:

SET 3"x1" STEEL PIPE W/ BERRIEN COUNTY BRASS CAP (MARKED 2000, 35988) IN MON BOX. THIS POSITION IS ACCEPTED AS A CAREFUL AND FAITHFUL  
PERPETUATION OF THE POSITION OF THE ORIGINAL CORNER.

Witnesses: EAST 25.74' K1-NE REMON  
S59°E 74.24' 9" PEAR TREE  
S49°E 58.14' 9" PEAR TREE  
S23°W 77.16' P. POLE W/ MDOT FLASHER  
N47°W 39.16' UTIL. POLE W/ MDOT FLASHER

Signed by A. K. Bartlett

Date 11/02/2000

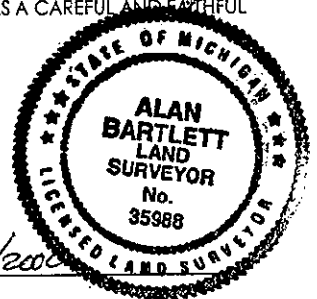

Surveyor's Michigan License No. 35988

**SURVEY &  
REMONUMENTATION**

FORM APPROVED BY MICHIGAN STATE BOARD OF PROFESSIONAL SURVEYORS, JAN. 28, 1971  
REVISED MAY 14, 1975  
REVISED JAN., 1983  
REVISED OCT., 1995

JAN 31 2001

LIBER 4

PAGE 236

SECTION