

RATIFIED BY THE BERRIEN COUNTY SURVEY PEER GROUP AS THE OFFICIAL CORNER UNDER MICHIGAN PUBLIC ACT 345 OF 1990

RECORDED

REMONUMENTATION LAND CORNER RECORDATION CERTIFICATE Filing Requirement of Act 74, Mich. P.A. 1970

Nov 23 3 05 PM '94

Berrien Township REGISTER OF DEEDS BERRIEN COUNTY MICHIGAN

10/27/94
For corners in BERRIEN (County)

	Located In:	Corner Code #
1. Public Land Survey	T 5S R 17W	A-1
Comments: T4S, R17W, A13	T _____ R _____	_____
T4S, R18W, M13	T _____ R _____	M-13
T5S, R18W, M1	T _____ R _____	_____
2. Property Controlling in Section	S _____ T _____ R _____	_____
3. Miscellaneous Property in Sec.	S _____ T _____ R _____	_____

Register of Deeds Stamp & File Number

4. Lot No. _____, Recorded Plat _____
5. Private Claims _____

	A	B	C	D	E	F	G	H	I	J	K	L	M
2	6		5		4		3		2		1		
3													
4	7		8		9		10		11		12		
5													
6	18		17		16		15		14		13		
7													
8	19		20		21		22		23		24		
9													
10	30		29		28		27		26		25		
11													
12	31		32		33		34		35		36		
13													

I, V.J. Strebs, in a field survey on November 17, 19 94, do hereby certify that under requirements of P.A. 74, Michigan P.A. of 1970, the corner points mentioned in lines 1 and 2 above were in conformance with regulations and rules therefore as required in the current manual of survey instructions of the United States Department of the Interior, Bureau of Land Management or by a decree of a Court of Law and/or that the corner points mentioned in lines 3, 4 and 5 above were in conformance with the rules of the Michigan Board of Land Surveyors or by a Decree of a Court of Law; established, re-established, monumented, re-monumented, recovered, found as expressed below:

NOTE: Not more than 4 corners, all in the same town and range, may be recorded on this certificate.

A. Description of original monument and accessories and/or subsequent restoration:

- 1827 - William Brookfield, D.S. (set post) Beech 28 - N56°E - 55 Links
- 1875 - Thomas Love (Found old stake, reset with stone 2 ft 3 in in long, 6 in in diameter) Apple 8" - S51½°W - 92 Links Sugar 5" - N20 ½ °E - 1.14 chains
- 1922 & 1943 James Hampton/John Howard Found Stone) 30" Maple - N.W. - 25.5' 30" Maple - N.E. - 17' 30" Maple - S.E. - 39' 10" Fir - N.E. - 44'
- 1989-Wightman & Associates (Brass cap in mon box) Nail in 36" Oak - N70°E - 16.74'

B. Description of corner evidence found and/or method applied in restoring or reestablishing corner:

- Nail in 36" Oak-S30°E-40.65'
- Riser Box - N80°W-26.80'

Found Michigan Brass cap over Stone in Monument Box


SURVEY & REMONUMENTATION
DEC 07 1995
COMMISSION

11/23/94 111#7594 A66
CORNER \$7.00
11/23/94 111#7594 A66
STATE REMON FEE \$2.00

C. Description of monument for corner and accessories established to perpetuate locating the position of the corner:

This corner is accepted as a careful and faithful perpetuation of the position of the original corner.
Set 1"x3ft long iron pipe W/B.C.R.P. Brass cap in monument box.
Rebar w/cap #25867 - West - 33.00'
Nail & Witness tag in 18" Maple - S30°W - 53.8'
Nail & Witness tag in Power Pole - S25°E - 77.15'
Nail & Witness tag in Power Pole - N20°E - 77.26'

Signed by V.J. Strebs
Surveyor's Michigan License No. 26469

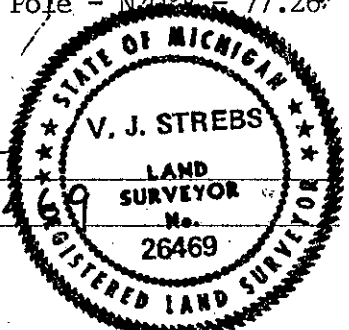

Date 21 NOVEMBER 1994