Section 4 Town 5 Range 17

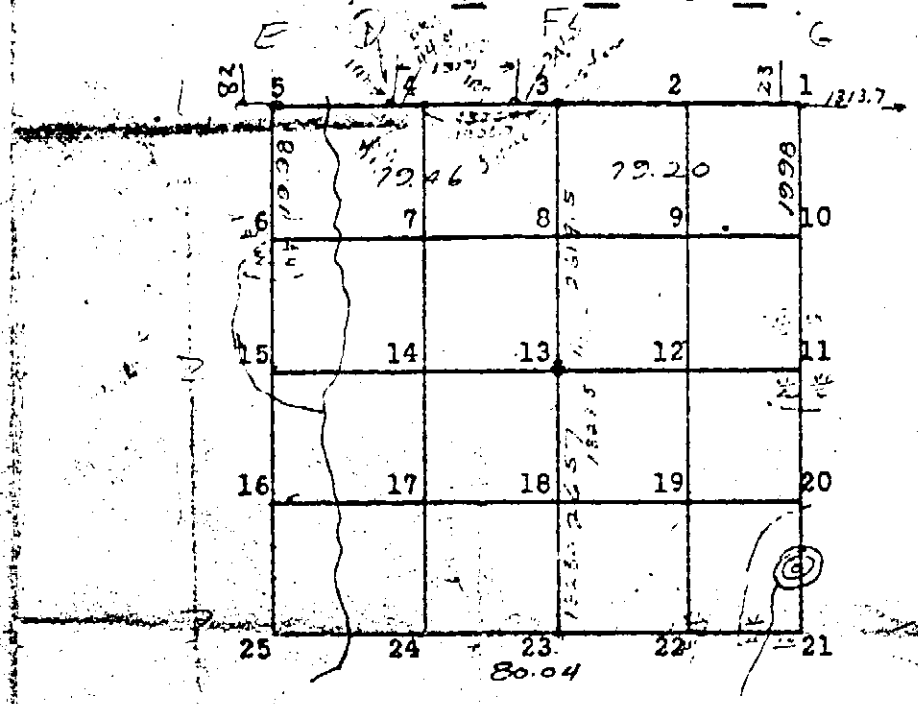

1 _____

2 _____

F-1 STONE 3 Cherry Row N 22.5 / Cor Cherry N 10°W — 22.1 / P.P. N 70°W — 42.6 | 2" Cherry Tree N 45°E 29.4 1973

COR 1 STONE 4 [illegible]

E-1 5 FLAT STONE with + I.P. NEXT TO IT | 4th Row Grape Post N 5°E - 32.80 / 1st Row Grape Post N 60°W. / 4" SASSAFRAS N 70°W - 7.25 1973

6 _____

7 _____

8 _____

9 _____

10 _____

11 witnesses from SW Surveying, watervliet

12 _____

F-2 13 cultivator tooth. fd. 3/74

14 _____

E-2 15 pointed Stone @ corner of Fence Post 1973

COR 10 16 Stone

COR 11 17 Iron { [illegible] Maple [illegible] Telepole [illegible] }

COR 12 18 Iron { 20" Maple [illegible] Fence Line N. 13.6' / " " E 29.2' }

19 _____

20 _____

fd. Brick & Post. G-3 21 Stone { 6" Elm N.W. 1.8' / 1st N+S Fence Line } fd. 5-22-74

COR 16 22 2" Post + Bricks { In N+S Fence Line / 9" W. Oak S. 11.4' / 16" Elm N. 41.9' } fd. 3/74

F-3 23 Plow Point { 15" Below Surface / 16" Hickory N 35°E 132.7' / 12" [illegible] N. 26.5' } fd. 3/74

24 _____

25 _____

A Iron { Cherry Row N 22.5 / Cor Cherry 1' 40°E - 37.3 / P.P. N 45°W - 51.5 } Corners in Sec. 33-4-17

B Iron { 1" [illegible] S 2.8 E 73.2 / 4" Cherry S. 17.9' / 16" Oak N 70°W 56.5' / 6" Cherry S.W. 25.4' / 8" " N 70 E. 67.0 } J. H. Dewey

SEC 33, T4S, R17W

T5S, R17W

PAGE 14